


STATE OF KANSAS
STATE CORPORATION COMMISSION

WELL PLUGGING RECORD

Give All Information Completely
Make Required Affidavit
Mail or Deliver Report to
Conservation Division
State Corporation Comm.
245 North Water
Wichita, KS 67202

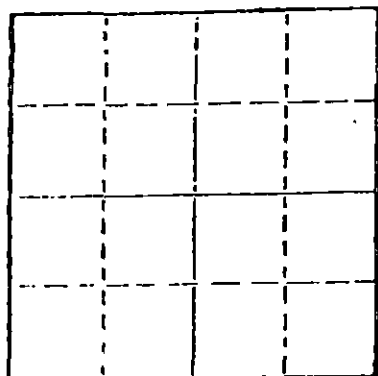

Kingman County. Sec. 16 Twp. 29S Rge. 6W E/W
Location as "NE/CNW1SW1" or footage from lines
SW SE SW
Lease Owner Graves Drilling Co., Inc.
Lease Name Matson Well No. 1
Office Address 910 Union Center, Wichita, Kansas 67202
Character of Well (Completed as Oil, Gas or Dry Hole)
Dry Hole
Date Well completed July 19 19 78
Application for plugging filed July 19 19 78
Application for plugging approved July 19 19 78
Plugging commenced July 19 19 78
Plugging completed July 19 19 78
Reason for abandonment of well or producing formation

If a producing well is abandoned, date of last production 19

Was permission obtained from the Conservation Division or its agents before plugging was commenced? Yes

Name of Conservation Agent who supervised plugging of this well William T. Owens
Producing formation Depth to top Bottom Total Depth of Well 4270'
Show depth and thickness of all water, oil and gas formations.

OIL, GAS OR WATER RECORDS

CASING RECORD

FORMATION	CONTENT	FROM	TO	SIZE	PUT IN	PULLED OUT
				8-5/8"	216'	None

Describe in detail the manner in which the well was plugged, indicating where the mud fluid was placed and the method or methods used in introducing it into the hold. If cement or other plugs were used, state the character of same and depth placed, from feet to feet for each plug set.

Mudded up with heavy mud to 230 feet. Pumped 40 sacks of cement through drill pipe with pump truck. Pushed plug and 1/2 sack hulls to 40 feet and pumped 12 sacks of cement through drill pipe with pump truck to base of well cellar. Plugged rat hole with 3 sacks of cement.

RECEIVED
STATE CORPORATION COMMISSION

JUL 25 1978 7-25-1978

CONSE. DIV.
Wichita, Kansas

(If additional description is necessary, use BACK of this sheet)

Name of Plugging Contractor Graves Drilling Co., Inc.
910 Union Center, Wichita, Kansas 67202

STATE OF KANSAS COUNTY OF SEDGWICK, ss.
John C. Graves (employee of owner) or (owner or operator)
of the above-described well, being first duly sworn on oath, says: That I have knowledge of the facts, statements, and matters herein contained and the log of the above-described well as filed and that the same are true and correct. So help me God.

(Signature) John C. Graves
910 Union Center, Wichita, Kansas 67202
(Address)

SUBSCRIBED AND SWORN TO before me this 24th day of July, 19 78

My commission expires January 18, 1982

Dorothy Galbraith
Notary Public.

ROTARY DRILLERS LOG

OPERATOR: Graves Drilling Co., Inc.
910 Union Center
Wichita, Kansas 67202

DRILLING COMMENCED: July 12, 1978

CONTRACTOR: Graves Drilling Co., Inc.
910 Union Center
Wichita, Kansas 67202

DRILLING COMPLETED: July 19, 1978

CASING RECORD: 5 Jts. 216' of used 8-5/8"
cemented with 200 sacks

LOCATION: Matson No. 1
SW SE SW
Section 16-29S-6W
Kingman County, Kansas

0 -	80	Sand and Clay
80 -	216	Red Rock
216 -	727	Red Bed and Shale
727 -	1594	Shale and Lime
1594 -	1860	Lime and Shale
1860 -	2652	Shale and Lime
2652 -	2835	Shale
2835 -	3050	Shale and Lime
3050 -	3150	Shale
3150 -	4150	Shale and Lime
4150 -	4270	Lime
4270		Rotary Total Depth

I hereby certify the foregoing statements to be true and correct to the best of my knowledge.

GRAVES DRILLING CO., INC.

RECEIVED
STATE CORPORATION COMMISSION
JUL 25 1978
CONSERVATION DIVISION
Wichita, Kansas

By

J. L. Graves

President

STATE OF KANSAS)
) SS.
SEDGWICK COUNTY)

Subscribed and sworn to before me, a Notary Public, this 24th day of July, 1978.

Dorothy Galbraith
Dorothy Galbraith Notary Public

My commission expires: January 18, 1982

