


WELL PLUGGING RECORD

Give All Information Completely
Make Required Affidavit
Mail or Deliver Report to:
Conservation Division
State Corporation Commission
212 No. Market
Wichita, Kansas

NORTH

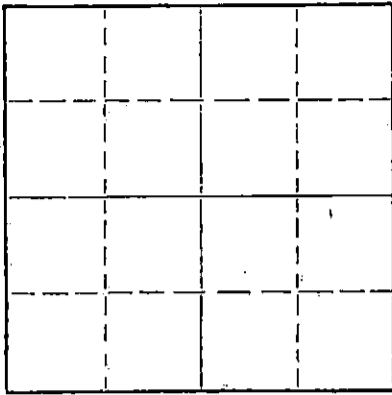

Locate well correctly on above
Section Plat

Kingman County, Sec. 21, Twp. 29S, Rge. ~~xx06~~ 6 (W)
Location as "NE/CNW&SW" or footage from lines C SE SE
Lease Owner Pickrell Drilling Company
Lease Name Mayer "B" Well No. 1
Office Address 705 Fourth National Bank Bldg., Wichita, Kansas
Character of Well (completed as Oil, Gas or Dry Hole) Dry Hole
Date well completed October 21 1969
Application for plugging filed October 21 1969
Application for plugging approved October 21 1969
Plugging commenced October 21 1969
Plugging completed October 21 1969
Reason for abandonment of well or producing formation Dry Hole

If a producing well is abandoned, date of last production 19____
Was permission obtained from the Conservation Division or its agents before plugging was commenced? Yes

Name of Conservation Agent who supervised plugging of this well Archie V. Elving
Producing formation _____ Depth to top _____ Bottom _____ Total Depth of Well 4555 Feet
Show depth and thickness of all water, oil and gas formations.

OIL, GAS OR WATER RECORDS

CASING RECORD

FORMATION	CONTENT	FROM	TO	SIZE	PUT IN	PULLED OUT
				8-5/8"	217'	None

Describe in detail the manner in which the well was plugged, indicating where the mud fluid was placed and the method or methods used in introducing it into the hole. If cement or other plugs were used, state the character of same and depth placed, from _____ feet to _____ feet for each plug set.

Bottom Plug @ 200' 25 sacks, plug @ 40' 10 Sacks Cement.

RECEIVED
STATE CORPORATION COMMISSION
NOV 3 1969
CONSERVATION DIVISION
Wichita, Kansas

11-3-1969

(If additional description is necessary, use BACK of this sheet)
Name of Plugging Contractor Pickrell Drilling Company
Address 705 Fourth National Bank Bldg., Wichita, Kansas

STATE OF Kansas, COUNTY OF Sedgwick, ss.
C. W. Sebitts (employee of owner) or (owner or operator) of the above-described well, being first duly sworn on oath, says: That I have knowledge of the facts, statements, and matters herein contained and the log of the above-described well as filed and that the same are true and correct. So help me God.

(Signature) *C. W. Sebitts*
C. W. Sebitts
705 Fourth National Bank Bldg., Wichita, Kansas
(Address)

SUBSCRIBED AND SWORN TO before me this 27th day of October, 1969

My commission expires May 10, 1970

L. M. Whiting
L. M. Whiting
Notary Public.

ROTARY DRILLING LOG

COMPANY: Pickrell Drilling Company
705 Fourth National Bank Bldg.
Wichita, Kansas 67202

Rotary Drilling Commenced 10/8/69

Rotary Drilling Completed 10/21/69

LOCATION: Mayer "B" # 1, C SE SE Section 21-29S-6W
Kingman County, Kansas

CONTRACTOR: PICKRELL DRILLING COMPANY
Wichita, Kansas

CASING RECORD: Run 11 Jts. 8-5/8" 28# surface casing set @ 217 KB. Cemented with
165 Sacks. Completed 6:15 P.M. October 8, 1969. Circulated.

No oil string run. D & A Plugged 2:15 P.M. October 21, 1969.

LOG

(Figures indicate bottom of formation — measurements from top of rotary bushing.)

60	Sand	C.F.S.
120	Shale	3358
218	Red Bed	3630
1340	Shale & Lime	3660
1645	Lime & Shale	3672
1785	Lime	3770
2525	Shale & Lime	3815
2850	Sandy Lime & Shale	4185
2900	Lime & Shale	4193
3090	Sandy & Lime	4525
3245	Shale & Lime	4531
3339	Sandy Lime Shale	4540
3475	Lansing	4545
3610	Lime & Shale	4555
3690	Kansas City Lime & Shale	
3730	Lime	S.L.M.
4172	Lime & Shale	3358
4215	Mississippian	Strap Diff. 1' = 55"
4405	Miss. Chert & Lime	
4431	Miss. Lime	
4459	Lime & Shale	Slope Tests
4478	Shale	2000
4492	Shale & Iron	2500
4536	Shale	3000
4555	Misner, RTD	3500
		4000
		4555

RECEIVED.
STATE CORPORATION COMMISSION
NOV 3 1969
CONSERVATION DIVISION
Wichita, Kansas

The undersigned, C. W. Sebitts, Attorney-in-Fact for PICKRELL DRILLING COMPANY, hereby certifies in behalf of said Company, that the above is a true and correct log of the formation encountered in drilling the above well as reflected by the Daily Drilling Reports.

PICKRELL DRILLING COMPANY

By C.W. Sebitts Attorney-in-Fact

STATE OF KANSAS }
COUNTY OF SEDGWICK } ss.:

On this 11 27th day of October, 19 69, before me the undersigned, a Notary Public, in and for the County and State aforesaid, personally appeared C. W. Sebitts, to me known to be the identical person who subscribed the name of PICKRELL DRILLING COMPANY to the foregoing instrument as its Attorney-in-Fact and acknowledged to me that he executed the same as his free and voluntary act and deed, and as his free and voluntary act and deed of such company, for the uses and purposes therein set forth.

Given under my hand and seal of office the day and year last above written.

My commission expires: May 10, 1970

L.M. Whiting
L.M. Whiting Notary Public