


STATE OF KANSAS  
STATE CORPORATION COMMISSION

Form CP-4

**R** WELL PLUGGING RECORD

Give All Information Completely  
Make Required Affidavit  
Mail or Deliver Report to:  
Conservation Division  
State Corporation Commission  
211 No. Broadway  
Wichita, Kansas

NORTH

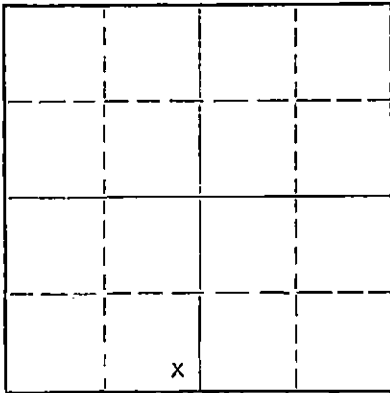

Locate well correctly on above  
Section Plat

KINGMAN County. Sec. 21 Twp. 29 Rge. 6 (E) W (W)  
Location as "NE/CNW%SW%" or footage from lines SE/4 SE/4 SW/4  
Lease Owner DAVIDOR & DAVIDOR, INC.  
Lease Name STUCKY Well No. 1  
Office Address 4515 N. SANTA FE, OKLAHOMA CITY, OKLAHOMA  
Character of Well (completed as Oil, Gas or Dry Hole) DRY HOLE  
Date well completed MAY 22 1963  
Application for plugging filed MAY 22 1963  
Application for plugging approved MAY 23 1963  
Plugging commenced MAY 28 1963  
Plugging completed MAY 30 1963  
Reason for abandonment of well or producing formation DRY HOLE

If a producing well is abandoned, date of last production 19  
Was permission obtained from the Conservation Division or its agents before plugging was commenced? YES

Name of Conservation Agent who supervised plugging of this well ARCHIE ELVING  
Producing formation \_\_\_\_\_ Depth to top \_\_\_\_\_ Bottom \_\_\_\_\_ Total Depth of Well 4600 Feet  
Show depth and thickness of all water, oil and gas formations.

OIL, GAS OR WATER RECORDS

CASING RECORD

FORMATION	CONTENT	FROM	TO	SIZE	PUT IN	PULLED OUT
				8-5/8"	240'	NONE
				4-1/2"	4599'	3151'

Describe in detail the manner in which the well was plugged, indicating where the mud fluid was placed and the method or methods used in introducing it into the hole. If cement or other plugs were used, state the character of same and depth placed, from \_\_\_\_\_ feet to \_\_\_\_\_ feet for each plug set.  
PUMPED 5 SACKS CEMENT TO 3620'. DISPLACED CEMENT WITH MUD. SHOT OFF PIPE AT 3151' AND PULLED. FILLED HOLE WITH MUD UP TO 240', BRIDGED 8-5/8" SURFACE PIPE (10') WITH ROCK UP TO 230'. MIXED 25 SACKS CEMENT AND SPOTTED IT AT 230', UP TO 160', THEN FILLED 8-5/8" SURFACE PIPE UP TO 35' AND BRIDGED WITH 10' OF ROCK UP TO 25', FILLED FROM 25' TO TOP OF SURFACE PIPE WITH 10 SACKS OF CEMENT.

RECEIVED  
STATE CORPORATION COMMISSION

JUN 14 1963

CONSERVATION DIVISION  
Wichita, Kansas

(If additional description is necessary, use BACK of this sheet)

Name of Plugging Contractor J. C. WOOD CASING PULLING COMPANY  
Address P. O. Box 65, EDMOND, OKLAHOMA

STATE OF OKLAHOMA, COUNTY OF OKLAHOMA, ss.  
HAROLD DAVIDOR (employee of owner) or (owner or operator) of the above-described well, being first duly sworn on oath, says: That I have knowledge of the facts, statements, and matters herein contained and the log of the above-described well as filed and that the same are true and correct. So help me God.

(Signature) Harold Davidor  
4515 N. SANTA FE, OKLAHOMA CITY, OKLA. PRESIDENT.  
(Address)

SUBSCRIBED AND SWORN TO before me this 13TH day of JUNE, 1963

Martha A. Marsh  
Notary Public.

My commission expires JULY 31, 1966