


STATE OF KANSAS  
STATE CORPORATION COMMISSION

WELL PLUGGING RECORD

Give All Information Completely  
Make Required Affidavit  
Mail or Deliver Report to:  
Conservation Division  
State Corporation Commission  
211 No. Broadway  
Wichita, Kansas

Kingman County. Sec. 21 Twp. 29S Rge. ### 6 (W)  
Location as "NE/CNW/SW" or footage from lines SE SE SW  
Lease Owner Pickrell Drilling Company  
Lease Name Stucky Well No. 1  
Office Address 705 Fourth Nat'l Bank Bldg.  
Character of Well (completed as Oil, Gas or Dry Hole) \_\_\_\_\_  
Date well completed April 25, 1958  
Application for plugging filed April 25, 1958  
Application for plugging approved April 25, 1958  
Plugging commenced April 25, 1958  
Plugging completed April 25, 1958  
Reason for abandonment of well or producing formation D & A

NORTH

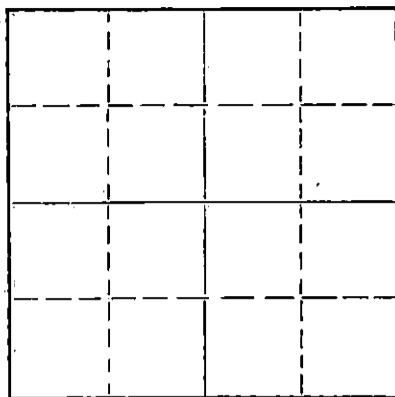

Locate well correctly on above  
Section Plot

If a producing well is abandoned, date of last production \_\_\_\_\_ 19\_\_\_\_  
Was permission obtained from the Conservation Division or its agents before plugging was commenced? Yes

Name of Conservation Agent who supervised plugging of this well Fred Hampel  
Producing formation \_\_\_\_\_ Depth to top \_\_\_\_\_ Bottom \_\_\_\_\_ Total Depth of Well 4600 Feet  
Show depth and thickness of all water, oil and gas formations.

OIL, GAS OR WATER RECORDS

CASING RECORD

FORMATION	CONTENT	FROM	TO	SIZE	PUT IN	PULLED OUT
				8 5/8"	240'	None

Describe in detail the manner in which the well was plugged, indicating where the mud fluid was placed and the method or methods used in introducing it into the hole. If cement or other plugs were used, state the character of same and depth placed, from \_\_\_\_\_ feet to \_\_\_\_\_ feet for each plug set.

Filled with heavy mud to 230', bridge hole and cement with 25 sacks cement. Then heavy mud to 30' below ground level, bridge hole and cement with 10 sacks cement to bottom of cellar.

RECEIVED  
STATE CORPORATION COMMISSION  
MAY 6 1958  
CONSERVATION DIVISION  
Wichita, Kansas  
5-6-1958

(If additional description is necessary, use BACK of this sheet)

Name of Plugging Contractor Pickrell Drilling Company  
Address 705 Fourth Nat'l Bank Bldg.

STATE OF Kansas, COUNTY OF Sedgwick, ss.  
C. W. Sebitts (employee of owner) or (owner or operator) of the above-described well, being first duly sworn on oath, says: That I have knowledge of the facts, statements, and matters herein contained and the log of the above-described well as filed and that the same are true and correct. So help me God.

(Signature) [Signature]  
705 Fourth Nat'l Bank Bldg.  
(Address)

SUBSCRIBED AND SWORN TO before me this May 5, 1958

My commission expires October 13, 1960 Lorraine M. Johnson Notary Public.

PLUGGING  
FILE SEC. 21 T. 29 R. 6W  
BOOK PAGE 90 LINE 35

ROTARY DRILLING LOG

COMPANY: Pickrell Drilling Company

Rotary Drilling Commenced 4/5/58

LOCATION: SE SE SW Sec. 21-29S-6W  
Kingman County, Kansas

Rotary Drilling Completed 4/25/58

CONTRACTOR: Stuckey #1  
PICKRELL DRILLING COMPANY  
Wichita, Kansas

CASING RECORD: 240' (6 jts.) 8 5/8" 22.7# Armco Spiralweld Casing, cemented  
with 115 sacks cement. Cement circulated  
No oil string. D & A

LOG

(Figures indicate bottom of formation — measurements from top of rotary bushing.)

Redrock, Shale & Shells	775'	Circ. for samples at 3742'
Shale & Shells	1085'	4175'
Shells & Lime	1200'	4190'
Lime & Shale	1590'	4528'
Lime	1705'	4540'
Lime & Shale	2350'	4545'
Lime	2480'	4580'
Lime & Shale	2830'	4600'
Lime, Shale & Sand	2980'	
Lime & Sand	3085'	
Lime, Sand & Shale	3237'	
Lime & Shale	3400'	
Lime	3554'	
Lime & Shale	3660'	
Lime	3828'	
Lime & Shale	3912'	
Lime	4050'	
Lime & Shale	4145'	
Shale & Lime	4167'	
Mississippi	4293'	
Mississippi Lime	4339'	
Mississippi	4416'	
Lime & Chert	4421'	
Shale & Lime	4456'	
Shale	4530'	
Lime & Shale	4545'	
Simpson	4600'	T.D.

RECEIVED  
STATE CORPORATION COMMISSION  
MAY 6 1958  
CONSERVATION DIVISION  
Wichita, Kansas

S.L.M. at 2500 - O.K.  
3500 - O.K.  
4500 - O.K.

Slope Test at 2500 00 off  
3500 00 off  
4500 00 off

The undersigned, C. W. Sebitts, Attorney-in-Fact for PICKRELL DRILLING COMPANY, hereby certifies in behalf of said Company, that the above is a true and correct log of the formation encountered in drilling the above well as reflected by the Daily Drilling Reports.

PLUGGING  
WIL SEC 27 29R 6W  
BOOK PAGE 90 LINE 35

PICKRELL DRILLING COMPANY  
By C. W. Sebitts  
Attorney-in-Fact

STATE OF KANSAS  
COUNTY OF SEDGWICK

On this 29th day of April, 1958, before me the undersigned, a Notary Public, in and for

the County and State aforesaid, personally appeared C. W. Sebitts, to me known to be the identical person who subscribed the name of PICKRELL DRILLING COMPANY to the foregoing instrument as its Attorney-in-Fact and acknowledged to me that he executed the same as his free and voluntary act and deed, and as the free and voluntary act and deed of such company, for the uses and purposes therein set forth.

Given under my hand and seal of office the day and year last above written:

My commission expires: October 13, 1960

Lorraine M. Johnson  
Notary Public