


STATE OF KANSAS
STATE CORPORATION COMMISSION

WELL PLUGGING RECORD

Give All Information Completely
Make Required Affidavit
Mail or Deliver Report to:
Conservation Division
State Corporation Commission
212 No. Market
Wichita, Kansas

Stanton County, Sec. 14 Twp. 298 Rge. (E) 43(W)

Location as "NE/CNW/SE" or footage from lines C -SE-NW
Lease Owner Sidwell Oil and Gas, Inc.
Lease Name D. E. & L. Cockrum Well No. 1
Office Address Box 2475, Pampa, Texas 79065
Character of Well (completed as Oil, Gas or Dry Hole) Dry Hole
Date well completed November 15, 19 71
Application for plugging filed November 15, 19 71
Application for plugging approved November 15, 19 71
Plugging commenced November 15, 19 71
Plugging completed November 15, 19 71
Reason for abandonment of well or producing formation Dry Hole

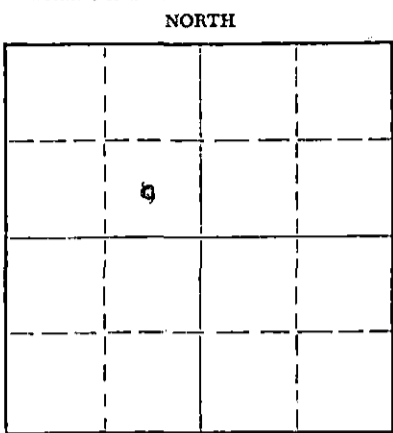

Locate well correctly on above Section Plat

If a producing well is abandoned, date of last production 19
Was permission obtained from the Conservation Division or its agents before plugging was commenced? Yes

Name of Conservation Agent who supervised plugging of this well Mr. Eddie Eades
Producing formation None Depth to top Bottom Total Depth of Well 5550 Feet
Show depth and thickness of all water, oil and gas formations.

OIL, GAS OR WATER RECORDS

CASING RECORD

FORMATION	CONTENT	FROM	TO	SIZE	PUT IN	PULLED OUT
Red Beds, Sand, Anhydrite	Water	0	1530	8 5/8	1530	0

Describe in detail the manner in which the well was plugged, indicating where the mud fluid was placed and the method or methods used in introducing it into the hole. If cement or other plugs were used, state the character of same and depth placed, from feet to feet for each plug set.

Mud 5550' to 1000'
50 Sacks Common Cement @ 1000' - 840'
Mud 840' - 45'
15 Sacks Common Cement @ 45' - 0

RECEIVED
STATE CORPORATION COMMISSION
DEC 17 1971
CONSERVATION DIVISION
Wichita, Kansas

12-17-1971

(If additional description is necessary, use BACK of this sheet)

Name of Plugging Contractor Service Drilling Co.
Address Box 910, Borger, Texas

STATE OF Texas, COUNTY OF Hutchinson, ss.
Roy W. Reese (employee of owner) or ~~owner~~ of the above-described

well, being first duly sworn on oath, says: That I have knowledge of the facts, statements, and matters herein contained and the log of the above-described well as filed and that the same are true and correct. So help me God.

(Signature) Roy W. Reese
Box 910 Borger, Texas (Address)

SUBSCRIBED AND SWORN to before me this 7th day of December, 19 71

My commission expires June 1, 1973

Wanda L. Goode
Notary Public.

DRILLER'S LOG

WELL NAME E. & L Cockrum

COMPANY OPERATING Sidwell Oil & Gas, Inc.
 ADDRESS OF COMPANY Box 2475, Pampa, Texas 79065

WELL LOCATION C $\frac{1}{4}$ SE $\frac{1}{4}$ NW $\frac{1}{4}$

3300 Ft. North of South Line,
1980 Ft. East of West Line, Sec. 14, Twp. 29S, Rge. 43W, Stanton County, Kansas

DRILLING STARTED 11-2, 19 71, DRILLING COMPLETED 11-15, 19 71
 WELL COMPLETED _____, 19 _____, WELL CONNECTED _____, 19 _____

ELEVATION 3539 Ft. Ground Level CHARACTER of WELL (Oil, Gas, Dry Hole) Dry Hole

OIL OR GAS SANDS OR ZONES - PERFORATIONS - ACIDIZING AND FRACTURING INFORMATION					
Name	From	To	No. of Shots	Gallons Used	Kind Used
None					

CASING RECORD

Size	Amount Set	Sacks of Cement	Amount Pulled
8 5/8	1530	565	None

FORMATION RECORD

Formation	Top	Bottom	Formation	Top	Bottom
Sand Gravel, Gyp	0	275			
Red Bed, Gyp, Shale	275	846			
Sand, Gyp	846	1349			
Shale, Anhydrite	1349	1723			
Sand, Shale	1723	2810			
Lime, Shale	2810	5041			
Shale	5041	5100			
Lime, Sand	5100	5211			
Lime, Shale	5211	5550	TD.		

RECEIVED
 STATE CORPORATION COMMISSION
 DEC 17 1971
 CONSERVATION DIVISION
 Wichita, Kansas

RESULTS OF INITIAL PRODUCTION TEST: _____

