


Give All Information Completely  
Make Required Affidavit  
Mail or Deliver Report to:  
Conservation Division  
State Corporation Commission  
211 No. Broadway  
Wichita, Kansas

WELL PLUGGING RECORD

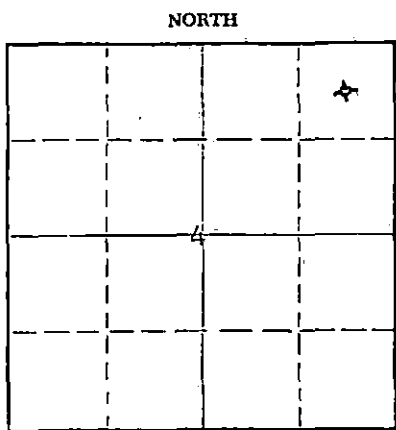

Stanton County, Sec. 4 Twp. 29S Rge. (E) 42 (W)  
Location as "NE/CNW\*SW\*" or footage from lines C NE/4 NE/4  
Lease Owner Graham-Michaelis Drilling, Inc.  
Lease Name Tucker Well No. 1-4  
Office Address 211 North Broadway, Wichita, Kansas 67202  
Character of Well (completed as Oil, Gas or Dry Hole) Dry Hole  
Date well completed August 31, 19 66  
Application for plugging filed August 31, 19 66  
Application for plugging approved (verbal) August 31, 19 66  
Plugging commenced August 31, 19 66  
Plugging completed August 31, 19 66  
Reason for abandonment of well or producing formation Dry Hole

If a producing well is abandoned, date of last production 19  
Was permission obtained from the Conservation Division or its agents before plugging was commenced? Yes - verbal

Name of Conservation Agent who supervised plugging of this well Edgar J. Eves, Sublette, Kansas  
Producing formation none Depth to top          Bottom          Total Depth of Well 5713 Feet  
Show depth and thickness of all water, oil and gas formations.

OIL, GAS OR WATER RECORDS

CASING RECORD

FORMATION	CONTENT	FROM	TO	SIZE	PUT IN	PULLED OUT
				8 5/8"	1589'	none

Describe in detail the manner in which the well was plugged, indicating where the mud fluid was placed and the method or methods used in introducing it into the hole. If cement or other plugs were used, state the character of same and depth placed, from          feet to          feet for each plug set.  
Hole filled with heavy drilling mud to 720', cement plug with 35 sacks cement at 720', filled with heavy drilling mud to 45', cement plug with 15 sacks cement at 45' to top of casing.


RECEIVED  
STATE CORPORATION COMMISSION  
SEP 13 1966  
CONSERVATION DIVISION  
Wichita, Kansas

(If additional description is necessary, use BACK of this sheet)  
Name of Plugging Contractor Graham-Michaelis Drilling, Inc.  
Address 211 North Broadway, Wichita, Kansas 67202

STATE OF Kansas COUNTY OF Sedgwick ss.  
Jack L. Yinger (employee of owner) owner of the above-described well, being first duly sworn on oath, says: That I have knowledge of the facts, statements, and matters herein contained and the log of the above-described well as filed and that the same are true and correct. So help me God.

(Signature) Jack L. Yinger  
211 North Broadway, Wichita, Kansas 67202  
(Address)

Subscribed and sworn to before me this 7th day of September 19 66  
My commission expires December 12, 1966  
Evelyn D. Evans Notary Public.

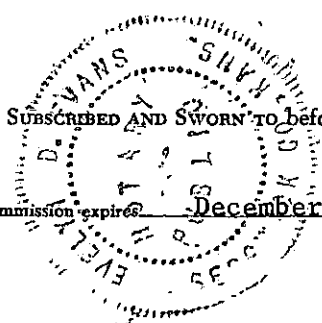

TUCKER NO. 1-4

## WELL RECORD:

## LOCATION:

C NE/4 NE/4 Section 4-29S-42W  
Stanton County, Kansas

Commenced: 8-16-66  
Completed: 8-31-66  
(Rotary)

## CONTRACTOR:

Graham-Michaelis Drilling, Inc.  
Liberal Division  
P. O. Box 1294  
Liberal, Kansas 67901

## CASING RECORD:

50 Joints 8-5/8" 24# Casing  
Cemented w/500 sx Lt. Wt. and  
200 sx Sunset

	<u>LOG</u>	
Surface Sand	0 -	420
Sand, Red Bed & Gyp	420 -	1091
Gyp	1091 -	1139
Gyp, Red Bed & Sand	1139 -	1501
Anhy & Shale	1501 -	2091
Red Bed	2091 -	2181
Lime & Shale	2181 -	2550
Lime, Shale & Sand	2550 -	2725
Lime & Shale	2725 -	5432
Lime	5432 -	5588
Lime & Shale	5588 -	5713

**RECEIVED**  
STATE CORPORATION COMMISSION

SEP 13 1966

CONSERVATION DIVISION  
Wichita, Kansas

5713' - Total Rotary Depth

The undersigned, Graham-Michaelis Drilling, Inc., Liberal Division, certifies that the above log is a true and correct copy of the formations encountered in drilling the above mentioned well, as taken from the Daily Drilling Report.

GRAHAM-MICHAELIS DRILLING, INC.  
LIBERAL DIVISION

By 

H. R. Michaelis

HRM/rw