

15-187-20293-0000

RECEIVED  
STATE CORPORATION COMMISSION

FORM CP-4


OCT - 2 1978

STATE OF KANSAS  
STATE CORPORATION COMMISSION

WELL PLUGGING RECORD CONSERVATION DIVISION  
Wichita, Kansas

Give All Information Completely  
Make Required Affidavit  
Mail or Deliver Report to  
Conservation Division  
State Corporation Comm.  
245 North Water  
Wichita, KS 67202

STANTON County. Sec. 32 Twp. 29S Rge. 40W E/W  
Location as "NE/CNW $\frac{1}{4}$ SW $\frac{1}{4}$ " or footage from lines  
2440' FNL & 2440' FWL of Section  
Lease Owner AMOCO PRODUCTION COMPANY  
Lease Name JULIAN, STANLEY A. Well No. 1  
Office Address P.O. Box 432 Liberal, Kansas 67901  
Character of Well (Completed as Oil, Gas or Dry Hole)  
Abandoned - Located on wrong spot  
Date Well completed September 26 1978  
Application for plugging filed See- Attached 19  
Application for plugging approved 19  
Plugging commenced September 26 1978  
Plugging completed September 26 1978  
Reason for abandonment of well or producing formation  
Drilled on wrong spot  
If a producing well is abandoned, date of last production  
N/A 19

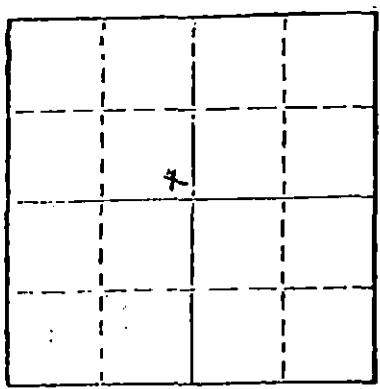

Locate well correctly on above  
Section Plot

Was permission obtained from the Conservation Division or  
its agents before plugging was commenced? YES

Name of Conservation Agent who supervised plugging of this well Clarence Thomas  
Producing formation NONE Depth to top Bottom Total Depth of Well 904  
Show depth and thickness of all water, oil and gas formations.

OIL, GAS OR WATER RECORDS

CASING RECORD

FORMATION	CONTENT	FROM	TO	SIZE	PUT IN	PULLED OUT
Sand		0	550	8.625	626	0
Rebbed		550	904			

Describe in detail the manner in which the well was plugged, indicating where the mud fluid  
was placed and the method or methods used in introducing it into the hold. If cement or other  
plugs were used, state the character of same and depth placed, from \_\_\_\_\_ feet to  
\_\_\_\_\_ feet for each plug set.

Plug well with 60 sacks of Class H cement. Spot first plug from 676' to 576' with  
35 sacks Class H cement. Spot second plug from 50' to surface, and fill rathole with  
25 sacks of Class H cement.

(If additional description is necessary, use BACK of this sheet)

Name of Plugging Contractor DOWELL Inc.

STATE OF KANSAS COUNTY OF STANTON, ss.  
Gale McCord (employee of owner) or (owner or operator)

of the above-described well, being first duly sworn on oath, says: That I have knowledge of  
the facts, statements, and matters herein contained and the log of the above-described well  
as filed and that the same are true and correct. So help me God.

(Signature) Gale McCord  
P.O. Box 432, Liberal, Kansas 67901  
(Address)

SUBSCRIBED AND SWORN TO before me this 27 day of September, 1978

C. E. Mullins C.E. Mullins  
Notary Public.

Appointment  
My Commission expires 8-10-80

