


STATE OF KANSAS  
STATE CORPORATION COMMISSION

WELL PLUGGING RECORD

Give All Information Completely  
Make Required Affidavit  
Mail or Deliver Report to  
Conservation Division  
State Corporation Comm.  
245 North Water  
Wichita, KS 67202

Stanton County, Sec. 7 Twp. 29S Rge. 42 xR/W  
Location as "NE/CNW 1/4 SW 1/4" or footage from lines  
1320' FNL & 660' FEL  
Lease Owner May Petroleum Inc.  
Lease Name McKee Well No. #1-7  
Office Address One Energy Square, Suite 1000, Dallas, Tex. 75206  
Character of Well (Completed as Oil, Gas or Dry Hole)  
Dry Hole  
Date Well completed 6-5-80 19  
Application for plugging filed 6-5-80 19  
Application for plugging approved 6-5-80 19  
Plugging commenced 6-5-80 19  
Plugging completed 6-5-80 19  
Reason for abandonment of well or producing formation  
Commercial quantities of oil not found  
If a producing well is abandoned, date of last production 19

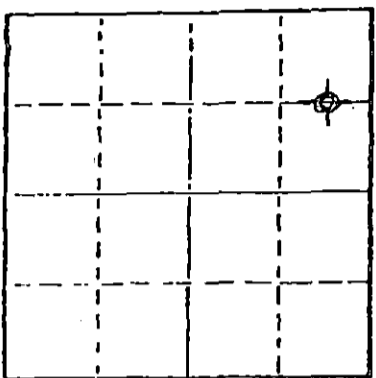

Locate well correctly on above  
Section Plat

Name of Conservation Agent who supervised plugging of this well Clarence Thomas  
Producing formation \_\_\_\_\_ Depth to top \_\_\_\_\_ Bottom \_\_\_\_\_ Total Depth of Well 5800'  
Show depth and thickness of all water, oil and gas formations.

OIL, GAS OR WATER RECORDS

CASING RECORD

FORMATION	CONTENT	FROM	TO	SIZE	PUT IN	PULLED OUT
				8 5/8"	1760'	None

Describe in detail the manner in which the well was plugged, indicating where the mud fluid was placed and the method or methods used in introducing it into the hold. If cement or other plugs were used, state the character of same and depth placed, from \_\_\_\_\_ feet to \_\_\_\_\_ feet for each plug set.

- Plug @ 3250' w/25 sx.
- Plug @ 2850' w/25 sx.
- Plug @ 1750' w/50 sx.
- Plug @ 825' w/25 sx.

JUN 23 1980

6-23-1980


(If additional description is necessary, use BACK of this sheet).

Name of Plugging Contractor Rains & Williamson Oil Co., Inc.

STATE OF Kansas COUNTY OF Sedgwick, ss.  
Wilson Rains, President of Rains & Williamson Oil Co., Inc. (employee of owner) or (owner or operator) of the above-described well, being first duly sworn on oath, says: That I have knowledge of the facts, statements, and matters herein contained and the log of the above-described well as filed and that the same are true and correct. So help me God.

(Signature) Wilson Rains  
435 Page Court, 220 W. Douglas, Wichita, Kansas 67202  
(Address)

SUBSCRIBED AND SWORN TO before me this 12 day of June, 1980

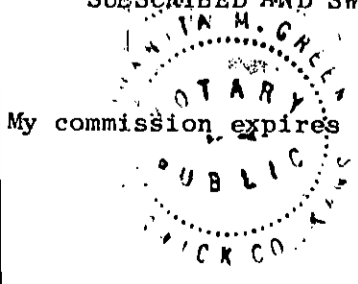

Juanita M. Green  
Juanita M. Green Notary Public.

DRILLER'S LOG

COMPANY: May Petroleum Inc.

SEC. 7 T. 29S R. 42W

WELL NAME: McKee #1-7

LOC. 1320' FNL & 660' FEL

COUNTY: Stanton

RIG NO. #5

TOTAL DEPTH 5800'

ELEVATION

COMMENCED: 5-23-80

COMPLETED: 6-5-80

CONTRACTOR: Rains & Williamson Oil Co., Inc.

CASING RECORD:

SURFACE: 8 5/8" @ 1760' w/650 sx. Lite, 1/4# floseal, 2% cc. and 200 sx. Class H, 2% cc.

PRODUCTION: D&A

LOG

(Figures Indicate Bottom of Formations)

Sand & Clay	1200
Redbed	1718
Shale	2610
Shale & Lime	2746
Lime & Shale	3267
Shale & Lime	3427
Lime & Shale	4265
Lime	4777
Shale & Lime	4928
Lime	5073
Lime & Shale	5604
Shale & Lime	5687
Lime & Shale	5800
<u>ROTARY TOTAL DEPTH</u>	<u>5800</u>

STANTON COUNTY RECORDS

JUN 27 1980

RECORDS SECTION

STATE OF Kansas )  
COUNTY OF Sedgwick ) SS:

I, Wilson Rains, President of Rains & Williamson Oil Co., Inc.  
upon oath state that the above and foregoing is a true and correct copy of the log of the  
McKee #1-7 well.

Wilson Rains  
Wilson Rains

Subscribed and sworn to before me this 12 day of June, 1980.

My Appointment Expires:  
10-4-83

Juanita M. Green  
Juanita M. Green

