


15-187-00219-0000

STATE OF KANSAS
STATE CORPORATION COMMISSION

WELL PLUGGING RECORD

Give All Information Completely
Make Required Affidavit
Mail or Deliver Report to:
Conservation Division
State Corporation Commission
800 Bitting Building
Wichita, Kansas

NORTH

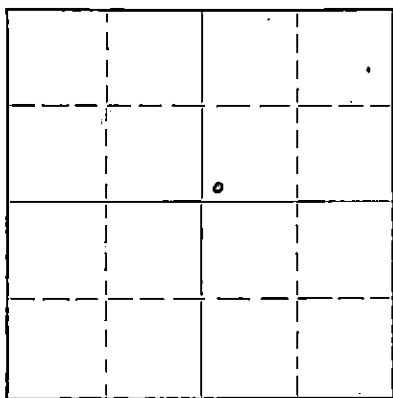

Locate well correctly on above
Section Flat

Stanton County. Sec. 17. Twp. 29. Rge. 40. (W)
Location as "NE/CNW $\frac{1}{4}$ SW $\frac{1}{4}$ " or footage from lines 150' N. & 150' E. of Center of Sec.
Lease Owner Kansas-Nebraska Natural Gas Co., Inc.
Lease Name Ray Well No. 1
Office Address Hastings, Nebraska
Character of Well (completed as Oil, Gas or Dry Hole) Dry
Date well completed April 26 19 54
Application for plugging filed August 24 19 54
Application for plugging approved August 25 19 54
Plugging commenced August 26 19 54
Plugging completed August 28 19 54
Reason for abandonment of well or producing formation Unable to Produce
Commercially
If a producing well is abandoned, date of last production 19
Was permission obtained from the Conservation Division or its agents before plugging was commenced? Yes

Name of Conservation Agent who supervised plugging of this well Gordon Farr, Lakin, Kansas
Producing formation Permian Depth to top 2236 Bottom 2332 Total Depth of Well 2354 Feet
Show depth and thickness of all water, oil and gas formations.

OIL, GAS OR WATER RECORDS

CASING RECORD

Formation	Content	From	To	Size	Put In	Pulled Out
Herington	S. Show Gas ^{W/Salt} Water	2236	2250	8-5/8	477	Cut off 4" Below
Krider	" " " "	2255	2274	5 1/2	2352	1295 G.L.
Winfield	Salt Water	2306	2326			

Describe in detail the manner in which the well was plugged, indicating where the mud fluid was placed and the method or methods used in introducing it into the hole. If cement or other plugs were used, state the character of same and depth placed, from feet to feet for each plug set.

Plugged back with sand from 2276 to 2230. Dumped 5 Sacks cement at 2230.
Top of Cement 2195. Set rock bridge at 450'. Dumped 20 Sacks Cement.
Top of Cement 385'. Filled with mud to 50. Dumped 15 Sacks Cement for Cap.

9-11-1954

RECEIVED
STATE CORPORATION COMMISSION
SEP 11 1954
CONSERVATION DIVISION
Wichita, Kansas

(If additional description is necessary, use BACK of this sheet)

Correspondence regarding this well should be addressed to Lawrence Holmstrom, Kansas-Nebraska Natural Gas Co., Inc.
Address Lakin, Kansas

STATE OF KANSAS, COUNTY OF KEARNY, ss.
Lawrence Holmstrom (employee of owner) or (owner or operator) of the above-described well,
being first duly sworn on oath, says: That I have knowledge of the facts, statements, and matters herein contained and the log of the above-described well as filed and that the same are true and correct. So help me God.

(Signature) Lawrence Holmstrom
Lakin, Kansas (Address)

SUBSCRIBED AND SWORN TO before me this 10th day of September, 1954
O. F. Beymer Notary Public.

My commission expires Oct 1, 1955

PLUGGING
FILE SEC 17 T 29 R 40W
BOOK PAGE 58 LINE 42

HONAKER DRILLING COMPANY
2008 LAKIN
GREAT BEND, KANSAS

DRILLERS LOG

Ray # 1
Sec: 17-29-40
Loc: 150' South and 150'
East of Center
Stanton County, Kansas

Comm: 3-21-54
Comp: 3-25-54
T. D. 2360'

Casing: 8 5/8" 460'
5 1/2" 2353'

Operator: Kansas-Nebraska Natural Gas Company, Inc.
Contractor: Honaker Drilling Company

ELEV. 3307 G.L.

0	200	Sand and clay	
200	395	Sand and gravel	
395	450	Clay and sand streaks	
450	479	Clay and shale	8 5/8" casing cemented @ 460' with
479	620	Blue shale and sand	300 sacks cement and 6 sacks
620	1200	Red bed	calcium chloride
1200	1650	Red bed and shale	
1650	2095	Gyp and shale	
2095	2360	Lime and shale	
2360		Total Rotary Depth	5 1/2" casing cemented @ 2353' with
			150 sacks cement

I certify that this is the true and correct copy
of the above log, to the best of my knowledge.

Joe J. Honaker

Notary Public

Subscribed and sworn to before me this 30th day of March 1954.

W. H. D. Fisher

Notary Public

My Commission Expires 6-25-55

RECEIVED
STATE CORPORATION COMMISSION
AUG 25 1954
CONSERVATION DIVISION
Wichita, Kansas

PLUGGING
FILED SEC 17 29 T 40W
DECK PAGE 58 LINE 42