


STATE OF KANSAS
STATE CORPORATION COMMISSION

WELL PLUGGING RECORD

Give All Information Completely
Make Required Affidavit
Mail or Deliver Report to
Conservation Division
State Corporation Comm.
245 North Water
Wichita, KS 67202

Stanton County, Sec. 7 Twp. 29S Rge. 40 E/W
Location as "NE/CNW $\frac{1}{4}$ SW $\frac{1}{4}$ " or footage from lines
2310' FEL X 2540' FSL
Lease Owner Amoco Production Company
Lease Name Trostle Gas Unit Well No. 1
Office Address P. O. Box 432, Liberal, KS 67901
Character of Well (Completed as Oil, Gas or Dry Hole)

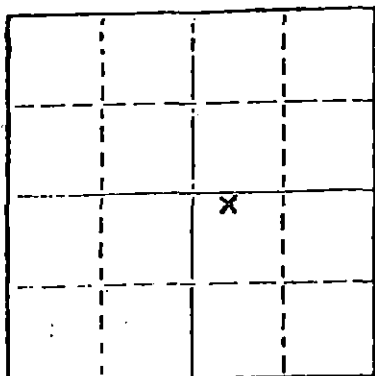

Locate well correctly on above
Section Plat

Dry Hole
Date Well completed 1-21-1978
Application for plugging filed 1-18-1978
Application for plugging approved 1-19-1978
Plugging commenced 1-21-1978
Plugging completed 1-21-1978
Reason for abandonment of well or producing formation
Lost circulation & unable to regain at 1632 feet.
If a producing well is abandoned, date of last production 19

Was permission obtained from the Conservation Division or
its agents before plugging was commenced? Yes

Name of Conservation Agent who supervised plugging of this well Frank Broadfoot
Producing formation _____ Depth to top _____ Bottom _____ Total Depth of Well 1632
Show depth and thickness of all water, oil and gas formations.

OIL, GAS OR WATER RECORDS

CASING RECORD

FORMATION	CONTENT	FROM	TO	SIZE	PUT IN	PULLED OUT
				8 5/8	640	0

Describe in detail the manner in which the well was plugged, indicating where the mud fluid
was placed and the method or methods used in introducing it into the hold. If cement or other
plugs were used, state the character of same and depth placed, from _____ feet to
_____ feet for each plug set.

Pump 250 SX 40-50 POZ MIX. WAITED 3 HRS. WELL STILL HAD VACUUM. SHUT-IN 19
HRS. PUMP 100 SX 40-60 POZ MIX. FILL CSG TO 4 FEET FROM SURFACE. CUT OFF 8 5/8
INCH CASING AND WELD ON CAP. WELL PLUGGED AND ABANDONED.

RECEIVED
STATE CORPORATION COMMISSION

JAN 26 1978 1-26-1978

CONSERVATION DIVISION
Wichita, Kansas

(If additional description is necessary, use BACK of this sheet)


Name of Plugging Contractor Dowell

STATE OF KANSAS COUNTY OF SEWARD, ss.
Gale McCord (employee of owner) or (owner or operator)
of the above-described well, being first duly sworn on oath, says: That I have knowledge of
the facts, statements, and matters herein contained and the log of the above-described well
as filed and that the same are true and correct. So help me God.

(Signature) Gale McCord Gale McCord
P.O. Box 432, Liberal, KS 67901 Admn. Supervisor
(Address)

SUBSCRIBED AND SWORN TO before me this 24 day of January, 1978

J. L. Dressen J. L. Dressen
Notary Public.

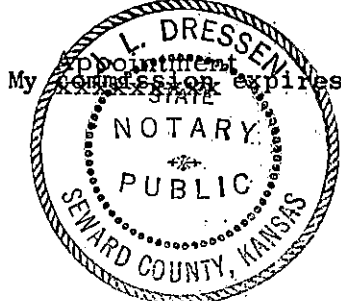

FORMATION RECORD

DESCRIBE EACH FORMATION DRILLED. INDICATE THICKNESS, CONTENT AND WHETHER DRY, OR OIL, GAS, OR WATER BEARING.

FORMATION	TOP	BOTTOM	FORMATION	TOP	BOTTOM
Sand, Shale, Red bed	-0-	640			
Red Bed	640	965			
Shale, Sand	965	1,284			
Sand	1,284	1,632			

7/26