

STATE OF KANSAS  
STATE CORPORATION COMMISSION

WELL PLUGGING RECORD

Give All Information Completely  
Make Required Affidavit  
Mail or Deliver Report to  
Conservation Division  
State Corporation Comm.  
245 North Water  
Wichita, KS 67202

Kingman County, Sec. 35 Twp. 29 Rge. 7 E/W  
Location as "NE/CNW $\frac{1}{4}$ SW $\frac{1}{4}$ " or footage from lines  
N/2 NE SW

Lease Owner Frank J. Black  
Lease Name Hibbs "A" Well No. 1  
Office Address Box 250, McPherson, Kansas 67460  
Character of Well (Completed as Oil, Gas or Dry Hole)  
oil


Date Well completed 19  
Application for plugging filed 19  
Application for plugging approved 19  
Plugging commenced September 26 1977  
Plugging completed October 6 1977  
Reason for abandonment of well or producing formation  
depleted

If a producing well is abandoned, date of last production 19

Was permission obtained from the Conservation Division or its agents before plugging was commenced? yes

Name of Conservation Agent who supervised plugging of this well Jasper Metz  
Producing formation Depth to top Bottom Total Depth of Well 4146'

Show depth and thickness of all water, oil and gas formations.

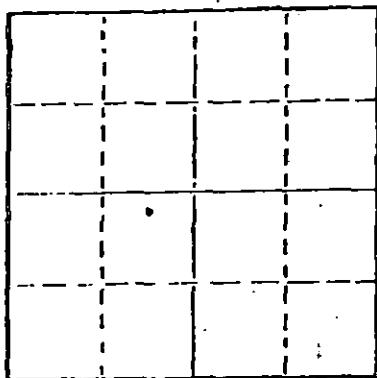

Locate well correctly on above Section Plan

OIL, GAS OR WATER RECORDS

CASING RECORD

FORMATION	CONTENT	FROM	TO	SIZE	PUT IN	PULLED OUT
		0	233'	8 5/8"	233'	none
			4136'	5 1/2"	4136'	3549.72

Describe in detail the manner in which the well was plugged, indicating where the mud fluid was placed and the method or methods used in introducing it into the hold. If cement or other plugs were used, state the character of same and depth placed, from feet to feet for each plug set.

Sanded back to 4100' and dumped 5 sacks of cement.

Set 12' rock bridge at 245' and plugged well with 4 1/2 yards of ready mix cement.

10-13-77 11:51 AM

(If additional description is necessary, use BACK of this sheet)

Name of Plugging Contractor PIPE PULLERS, INC.  
Box 128, Ellinwood, Kansas 67526

STATE OF KANSAS COUNTY OF BARTON ss.  
Evelyn Roth (employee of owner) or (owner-or-operator) of the above-described

well, being first duly sworn on oath, says: That I have knowledge of the facts, statements, and matters herein contained and the log of the above-described well as filed and that the same are true and correct. So help me God.

(Signature) Evelyn Roth  
Ellinwood, Kansas (Address)

Subscribed and Sworn to before me this 10th day of October 1977

My commission expires

JENNY KASSELMAN  
NOTARY PUBLIC  
BARTON COUNTY, KANSAS  
MY COMM. EXP. JULY 16, 1978

Jenny Kaselman  
Notary Public

DRILLERS' LOG

SHAFFER OIL COMPANY  
404 Wolcott Building  
Hutchinson, Kansas

No. 1 Hibbs 'A'  
N/2 NE SW, Sec. 35-29S-7W  
Kingman County, Kansas

Elev: 1486 K.B.

Commenced: 3-1-76  
Completed: 3-8-76

Surface Casing: 233' of  
8-5/8" cemented w/175 sx  
common cement, 2% Gel, 3% cc.  
3-1-76

<u>FORMATION</u>	<u>DEPTH</u>
Surface Hole	0 - 240
Red Bed & Shale	240 - 789
Red Bed, Shale and lime streaks	789 - 890
Shale	890 - 1485
Shale & Lime	1485 - 3410
Lime & Shale	3410 - 3780
Lime	3780 - 4146 RTD

RECEIVED  
STATE CORPORATION COMMISSION  
JUL 11 1977  
CONSERVATION DIVISION  
Wichita, Kansas

I do hereby certify that the foregoing statements are true and correct to the best of my knowledge and belief.

D N B DRILLING, INC.

*James L. Donelson*  
JAMES L. DONELSON

STATE OF KANSAS: ss:

Subscribed and sworn to before me this 19th day of March 1976.

*Ella Priess*  
Ella Priess, Notary Public

*Ella Priess*  
STATE NOTARY PUBLIC  
Sedgwick County, Kansas  
My Com. Expires Aug. 25, 1978