


15-095-00739-0000

RECEIVED
STATE CORPORATION COMMISSION
SEP 4 1970
CONSERVATION DIVISION
Wichita, Kansas

Form CP-4

WELL PLUGGING RECORD

STATE OF KANSAS
STATE CORPORATION COMMISSION
Give All Information Completely
Make Required Affidavit
Mail or Deliver Report to:
Conservation Division
State Corporation Commission
212 No. Market
Wichita, Kansas 67202
NORTH

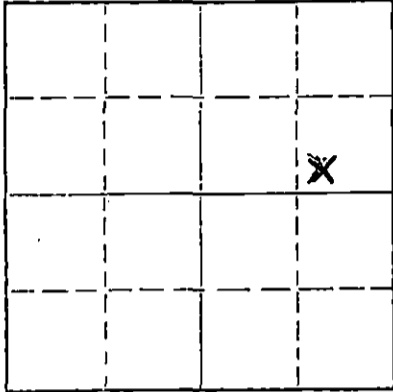

Locate well correctly on above Section Plat

Kingman County, Sec. 35 Twp. 29 Rge. 7 (E) W (W)

Location as "NE/CNWxSWx" or footage from lines SW SE NE

Lease Owner Oasis Petroleum Inc.

Lease Name Coon Well No. #1

Office Address 800 Sutton Place ; Wichita, Kansas 67202

Character of Well (completed as Oil, Gas or Dry Hole)

Date well completed 1970

Application for plugging filed August 1970

Application for plugging approved August 1970

Plugging commenced August 19 1970

Plugging completed August 21 1970

Reason for abandonment of well or producing formation

If a producing well is abandoned, date of last production 19

Was permission obtained from the Conservation Division or its agents before plugging was commenced? Yes

Name of Conservation Agent who supervised plugging of this well Russell Biberstein

Producing formation Depth to top Bottom Total Depth of Well Feet

Show depth and thickness of all water, oil and gas formations.

OIL, GAS OR WATER RECORDS

CASING RECORD

FORMATION	CONTENT	FROM	TO	SIZE	PUT IN	PULLED OUT
				8 5/8	231	None
				5 1/2	4242	3290

Describe in detail the manner in which the well was plugged, indicating where the mud fluid was placed and the method or methods used in introducing it into the hole. If cement or other plugs were used, state the character of same and depth placed, from feet to feet for each plug set.

August 19, 1970 Plugged off bottom. Dumped sand to 4075'. Mixed and dumped 5 sx of cement to 4035'.

August 21, 1970 Plugged off top. Set 10' rock bridge from 215' to 225'. Filled 8 5/8" surface casing with 3000 lb. P.S.I. ready mix concrete, from 215' to base of cellar.

Name of Plugging Contractor RUSS CASING PULLING, INC. (If additional description is necessary, use BACK of this sheet)

Address P. O. BOX 1082 ; GREAT BEND, KANSAS 67530


STATE OF KANSAS, COUNTY OF SEDGWICK, ss. Jack G. Paulsen (employee of owner) owner or operator of the above-described well, being first duly sworn on oath, says: That I have knowledge of the facts, statements, and matters herein contained and the log of the above described well as filed and that the same are true and correct. So help me God.

(Signature) Jack G. Paulsen

Jack G. Paulsen
800 Sutton Place, Wichita, Kansas
(Address)

Subscribed and sworn to before me this 3rd day of September, 1970.

My commission expires June 28, 1974. Jean S. Taylor Notary Public.

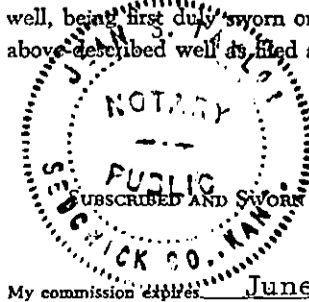

O. A. Sutton - Coon #1
SW SE NE Section 35-29S-7W
Kingman County, Kansas

Commenced - 8/19/60
Completed - 8/31/60
Elevation - 1483 KB.B
Casing - 231' (used) 8-5/8" casing Cemented with 200 sx of HA5 cement

DRILLERS LOG

40 - 231	Shale
231 - 510	Shale/Red Bed
510 - 1073	Shale/Lime Stks.
1073 - 1275	Shale and Lime
1275 - 1475	Shale and Lime
1475 - 1625	Lime and Shale
1625 - 1770	Shale and Lime
1770 - 2005	Lime and Shale
2005 - 2175	Lime and Shale
2175 - 2296	Lime and Shale
2296 - 2480	Lime and Shale
2480 - 2660	Shale and Lime
2660 - 2805	Lime and Shale
2805 - 2925	Lime and Shale
2925 - 3060	Lime and Shale
3060 - 3300	Lime and Shale
3300 - 3382	--
3382 - 3420	Lime
3420 - 3535	Lime
3535 - 3650	Lime
3650 - 3705	Lime
3705 - 3780	Lime
3780 - 3853	Lime
3852 - 3925	Lime
3925 - 4000	Lime
4000 - 4080	Lime
4080 - 4099	Lime/Shale
4099 - 4125	Miss
4125 - 4150	Miss
4150 - 4185	Lime
4185 - 4241	Miss/Lime
4241	Total Depth

RECEIVED
STATE CORPORATION COMMISSION
AUG 19 1970
CONSERVATION DIVISION
Wichita, Kansas

STATE OF KANSAS)
) ss
SEDGWICK COUNTY)

I, the undersigned, being duly sworn on oath, state that the above Drillers Log is true and correct to the best of my knowledge and belief and according to the records of this office.

J. S. SUTTON DRILLING COMPANY

By James S. Sutton, Jr.

Subscribed and sworn to before me this 2nd day of September 1960.

Henry D. Ficken
Notary Public

My Commission expires February 27, 1961.