

CARD MUST BE TYPED

State of Kansas  
**NOTICE OF INTENTION TO DRILL**  
(see rules on reverse side)

2025  
CARD MUST BE SIGNED

Starting Date: 12-15-84  
month day year

API Number 15-151-21,530-00-00

OPERATOR: License # 9158  
Name Case Oil & Gas, Inc.  
Address 107 W. Fourth  
City/State/Zip Pratt, Kansas 67124  
Contact Person Stan Case  
Phone (316) 672-9347

C. NW SW Sec. 6. Twp 28. S, Rge. 14.  East  West  
(location)

1980 Ft North from Southeast Corner of Section  
4620 Ft West from Southeast Corner of Section  
(Note: Locate well on Section Plat on reverse side)

CONTRACTOR: License # 5829  
Name Aldebaran Drilling Co., Inc.  
City/State Pratt, Kansas

Nearest lease or unit boundary line 660 feet.  
County Pratt  
Lease Name Schoonover Well# 1

Well Drilled For: Well Class: Type Equipment:  
 Oil  Swd  Infield  Mud Rotary  
 Gas  Inj  Pool Ext.  Air Rotary  
 OWWO  Expl  Wildcat  Cable

Domestic well within 330 feet:  yes  no  
Municipal well within one mile:  yes  no

If OWWO: old well info as follows:

Operator  
Well Name  
Comp Date Old Total Depth  
Projected Total Depth 5000 feet  
Projected Formation at TD Simpson Sand  
Expected Producing Formations Mississippi

Depth to Bottom of fresh water 100-185 mhc feet  
Lowest usable water formation 100 feet  
Depth to Bottom of usable water 100-250 feet  
Surface pipe by Alternate: 1  2   
Surface pipe to be set 400 feet  
Conductor pipe if any required none feet  
Ground surface elevation feet MSL  
This Authorization Expires 6-11-85  
Approved By 12-11-84

I certify that we will comply with K.S.A. 55-101, et seq., plus eventually plugging hole to K.C.C. specifications.

Date 12-10-84 Signature of Operator or Agent Stan Case


Title Operations Supervisor

MHC/WOHE 12/11/84  
Form C-1 4/84

Must be filed with the K.C.C. five (5) days prior to commencing well  
This card void if drilling not started within six (6) months of date received by K.C.C.

**Important procedures to follow:**

**A Regular Section of Land**  
**1 Mile = 5,280 Ft.**

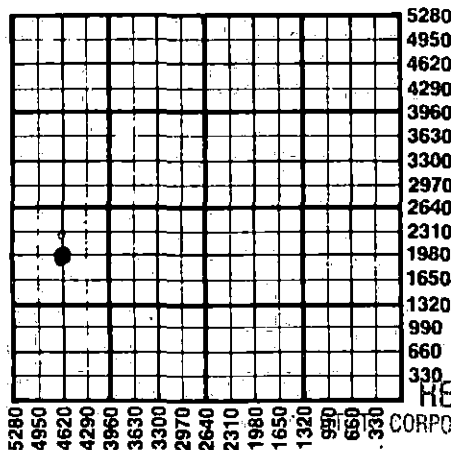

1. Notify District office before setting surface casing.
2. Set surface casing by circulating cement to the top.
3. File completion forms ACO-1 with K.C.C. within 90 days of well completion, following instructions on ACO-1, side 1, and including copies of wireline logs.
4. Notify District office 48 hours prior to old well workover or re-entry.
5. Prior to plugging, prepare a plugging plan, then obtain agreement from the appropriate district office for an approved plugging plan.
6. Submit plugging report (CP-4) to K.C.C. after plugging is completed.
7. Obtain an approved injection docket number before disposing of salt water.
8. Notify K.C.C. within 10 days when injection commences or terminates.
9. If an alternate 2 completion, cement in the production pipe from below any usable water to surface within 120 days of spud date.

RECEIVED

CORPORATION COMMISSION

DEC 11 1984  
12-11-84  
CONSERVATION DIVISION  
Wichita, Kansas

State Corporation Commission of Kansas  
Conservation Division  
200 Colorado Derby Building  
Wichita, Kansas 67202  
(316) 263-3238