

CARD MUST BE TYPED

State of Kansas NOTICE OF INTENTION TO DRILL

(see rules on reverse side)

CARD MUST BE SIGNED

Starting Date: 11 20 84
month day year

API Number 15- 151-20,122

OPERATOR: License # KCC # 4004 OP
Name N & G OIL COMPANY, INC.
Address P.O. BOX 1138
City/State/Zip PAMPA, TEXAS 79066-1138
Contact Person JOHN W. NORRIS
Phone 806/669-7424

C SW NW Sec 5 Twp 28 S, Rge 14
(location) East West

3300 Ft North from Southeast Corner of Section
4620 Ft West from Southeast Corner of Section
(Note: Locate well on Section Plat on reverse side)

CONTRACTOR: License #
Name
City/State

Nearest lease or unit boundary line 660 feet.
County PRATT

Lease Name HALL Well# 1

Domestic well within 330 feet: yes no

Municipal well within one mile: yes no

Well Drilled For: Well Class: Type Equipment:
 Oil Swd Infield Mud Rotary
 Gas Inj Pool Ext. Air Rotary
 OWWO Expl Wildcat Cable

Depth to Bottom of fresh water 190 feet

Lowest usable water formation PERMAIN

Depth to Bottom of usable water 250 feet

Surface pipe by Alternate: 1 2

Surface pipe set 419 feet

Conductor pipe if any required

Ground surface elevation APP. 2004 feet MSI

This Authorization Expires 5-8-85

Approved By 11-8-84

If OWWO: old well info as follows:

Operator LEE PHILLIPS OIL CO.

Well Name HALL # 1

Comp Date ~~DRY HOLE~~ Old Total Depth 4624'

Projected Total Depth 4624' 4-2-69

Projected Formation at TD SIMPSON

Expected Producing Formations MISSISSIPPI

I certify that we will comply with K.S.A. 55-101, et seq., plus eventually plugging hole to K.C.C. specifications.

Date 11/6/84 Signature of Operator or Agent


Vice President

MHC/KONE 11/84 Form C-1 4/84

Must be filed with the K.C.C. five (5) days prior to commencing well
 This card void if drilling not started within six (6) months of date received by K.C.C.

Important procedures to follow :

A Regular Section of Land
1 Mile = 5,280 Ft.

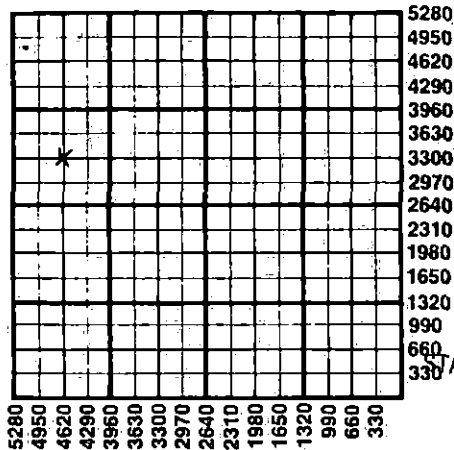

1. Notify District office before setting surface casing.
 2. Set surface casing by circulating cement to the top.
 3. File completion forms ACO-1 with K.C.C. within 90 days of well completion, following instructions on ACO-1, side 1, and including copies of wireline logs.
 4. Notify District office 48 hours prior to old well workover or re-entry.
 5. Prior to plugging, prepare a plugging plan, then obtain agreement from the appropriate district office for an approved plugging plan.
 6. Submit plugging report (CP-4) to K.C.C. after plugging is completed.
 7. Obtain an approved injection docket number before disposing of salt water.
 8. Notify K.C.C. within 10 days when injection commences or terminates.
- If an alternate 2 completion, cement in the production pipe from below any usable water to surface within 120 days of spud date.

RECEIVED
 STATE CORPORATION COMMISSION

NOV 08 1984
 11-8-84
 CONSERVATION DIVISION
 Wichita, Kansas

State Corporation Commission of Kansas
 Conservation Division
 200 Colorado Derby Building
 Wichita, Kansas 67202
 (316) 263-3238