

CARD MUST BE TYPED

State of Kansas

CARD MUST BE SIGNED

NOTICE OF INTENTION TO DRILL

(see rules on reverse side)

Expected Spud Date.....10.....5.....88.....
month day year

API Number 15- 151-21,903-00-60

OPERATOR: License # 3918.....

SW-NW Sec. 20 Twp. 28 S, Rg 14 XX West

NameSporran Oil Company.....

Address3814 N. Holiday Hill Rd. #414.....

City/State/Zip Midland, Texas 79707.....

Contact Person J. Morrison.....

Phone915/699-7589.....

3300 Ft. from South Line of Section
4620 Ft. from East Line of Section

(Note: Locate well on Section Plat on reverse side)

Nearest lease or unit boundary line660..... feet

County.....Pratt.....

Lease Name..Sillin..... Well #.1.....

Ground surface elevation ...2050..... feet MSL

Domestic well within 330 feet: _____yes XXXno

Municipal well within one mile: _____yes XXXno

CONTRACTOR: License # 5418.....

NameAllen Drilling.....

City/State...Great Bend, Kansas.....

Well Drilled For: Well Class: Type Equipment:

XX Oil _____ Storage _____ Infield XX Mud Rotary

_____ Gas _____ Inj _____ Pool Ext. _____ Air Rotary

_____ OWWO _____ Expl XX Wildcat _____ Cable

Depth to bottom of fresh water.....150.....

Depth to bottom of usable water260.....

Surface pipe by Alternate: IX 2'

Surface pipe planned to be set....300!.....

Conductor pipe required.....None.....

Projected Total Depth5000..... feet

Formation.....Arbuckle.....

If OWWO: old well info as follows:

Operator

Well Name

Comp Date..... Old Total Depth.....

I certify that well will comply with K.S.A. 55-101, et seq., plus eventually plugging hole to KCC specifications.

Date ...10/04/88.... Signature of Operator or Agent J. Morrison Title...Owner.....

For KCC Use:

Conductor Pipe Requiredfeet; Minimum Surface Pipe Required280..... feet per Alt. ① X

This Authorization Expires 4-4-89 Approved By LKM 10-4-88


EFFECTIVE DATE: 10-9-88

Must be filed with the K.C.C. five (5) days prior to commencing well
This card void if drilling not started within six (6) months of date received by K.C.C.

Important procedures to follow:

1. Notify District office before setting surface casing.
2. Set surface casing by circulating cement to the top.
3. File completion forms ACO-1 with K.C.C. within 120 days of well spud date, following instructions on ACO-1, side 1, and including copies of wireline logs.
4. Notify District office 48 hours prior to old well workover or re-entry.
5. Prior to filing Intent, prepare a proposed plugging plan in case well is D & A, then obtain approval of plan when calling district office prior to setting surface pipe.
6. Submit plugging report (CP-4) to K.C.C. after plugging is completed.
7. Obtain an approved injection docket number before disposing of salt water.
8. Notify K.C.C. within 10 days when injection commences or terminates.
9. If an alternate 2 completion, cement in the production pipe from below any usable water to surface within 120 days of spud date.

A Regular Section of Land
1 Mile = 5,280 Ft.

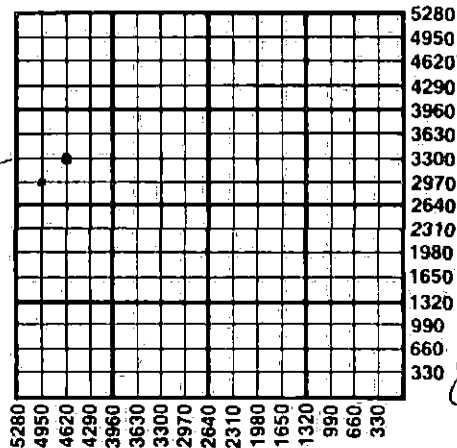

10/17/88
Wad
88

State Corporation Commission of Kansas
Conservation Division
200 Colorado Derby Building
Wichita, Kansas 67202-1212
(316) 263-3238