

CARD MUST BE TYPED

State of Kansas

CARD MUST BE SIGNED

NOTICE OF INTENTION TO DRILL

Expected Spud Date. 8 3 88 (see rules on reverse side) month day year

API Number 15-151-20,181-A -00-01 VO
SW SW SE Sec. 25 Twp. 28 S, Rg. 14 East
330' West
2310' Ft. from South Line of Section
Ft. from East Line of Section

OPERATOR: License # 3536
Name RAMCO Drilling Services, Inc.
Address 127 Lee Street, P. O. Box 99
City/State/Zip Belpre, OH 45714
Contact Person David Gocke
Phone 614-423-5422

(Note: Locate well on Section Plat on reverse side)
Nearest lease or unit boundary line 330' feet
County Pratt
Lease Name Hertlein Well # 1 (OWWO)

CONTRACTOR: License # 5422
Name Abercrombie Drilling, Inc.
City/State Wichita, KS 67202

Ground surface elevation feet MSL
Domestic well within 330 feet: yes X no
Municipal well within one mile: yes X no

Well Drilled For: Well Class: Type Equipment:
X Oil Storage Infield Mud Rotary
Gas Inj X Pool Ext. Air Rotary
X OWWO Expl Wildcat Cable

Depth to bottom of fresh water 200' 250'
Depth to bottom of usable water 200' 250'
Surface pipe by Alternate: Set 1 X 2

If OWWO: old well info as follows:
Operator Edmiston Oil Company
Well Name Hertlein #1
Comp Date 9-30-71 Old Total Depth 4544'

Surface pipe planned to be set 406' Set
Conductor pipe required None
Projected Total Depth 4544' feet
Formation Simpson

I certify that well will comply with K.S.A. 55-101, et seq., plus eventually plugging hole to KCC specifications.
Date 7-27-88 Signature of Operator or Agent Title Abercrombie Drilling, Inc. Vice President

For KCC Use:
Conductor Pipe Required feet; Minimum Surface Pipe Required 406 feet per Alt. 1 X
This Authorization Expires 1-27-89 Approved By 7-27-88


EFFECTIVE DATE: 8-1-88

Must be filed with the K.C.C. five (5) days prior to commencing well
This card void if drilling not started within six (6) months of date received by K.C.C.

Important procedures to follow:

1. Notify District office before setting surface casing.
2. Set surface casing by circulating cement to the top.
3. File completion forms ACO-1 with K.C.C. within 120 days of well spud date, following instructions on ACO-1, side 1, and including copies of wireline logs.
4. Notify District office 48 hours prior to old well workover or re-entry.
5. Prior to filing Intent, prepare a proposed plugging plan in case well is D & A, then obtain approval of plan when calling district office prior to setting surface pipe.
6. Submit plugging report (CP-4) to K.C.C. after plugging is completed.
7. Obtain an approved injection docket number before disposing of salt water.
8. Notify K.C.C. within 10 days when injection commences or terminates.
9. If an alternate completion, cement in the production pipe from below any usable water to surface within 120 days of spud date.

A Regular Section of Land
1 Mile = 5,280 Ft.

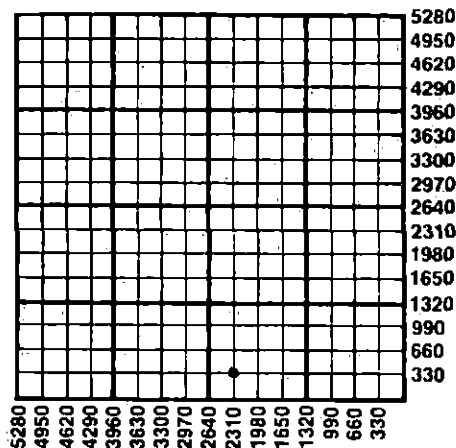

7-27-88
State Corporation Commission of Kansas
Conservation Division
Wichita, Kansas
200 Colorado Derby Building
Wichita, Kansas 67202-1212
(316) 263-3238