

CARD MUST BE TYPED

State of Kansas  
**NOTICE OF INTENTION TO DRILL**  
(see rules on reverse side)

CARD MUST BE SIGNED

Starting Date: 8-31-84  
month day year

API Number 15- 151-21,476-00-00

OPERATOR: License # 8059  
Name Robert-Gay Energy Enterprises, Inc.  
Address 1006 North Main  
City/State/Zip Hutchinson, Ks 67501  
Contact Person Robert L. Taylor  
Phone 316-669-8164

SE/4 Sec. 1 Twp. 28 S, Rge. 15  East  
(location)  West

CONTRACTOR: License # 8059  
Name Robert-Gay Energy  
City/State Hutchinson, Ks 67501

1400 Ft North from Southeast Corner of Section  
440 Ft West from Southeast Corner of Section  
(Note: Locate well on Section Plat on reverse side)

Well Drilled For: Well Class: Type Equipment:  
 Oil  Swd  Infield  Mud Rotary  
 Gas  Inj  Pool Ext.  Air Rotary  
 OWWO  Expl  Wildcat  Cable

Nearest lease or unit boundary line 440 feet.  
County Pratt  
Lease Name Cosby Well# 4 "RG"

Domestic well within 330 feet:  yes  no  
Municipal well within one mile:  yes  no

If OWWO: old well info as follows:

Operator .....  
Well Name .....  
Comp Date ..... Old Total Depth .....  
Projected Total Depth 4600 feet  
Projected Formation at TD Kinderhook  
Expected Producing Formations Kinderhook

Depth to Bottom of fresh water 200 feet  
Lowest usable water formation .....  
Depth to Bottom of usable water 300 feet  
Surface pipe by Alternate: 1  2   
Surface pipe to be set 300 feet  
Conductor pipe if any required none feet  
Ground surface elevation 2027 feet MSL  
This Authorization Expires 3-1-85  
Approved By 8-29-84 *R*


I certify that we will comply with K.S.A. 55-101, et seq., plus eventually plugging hole to K.C.C. specifications.

Date 8-28-84 Signature of Operator or Agent Robert L. Taylor Title President

Must be filed with the K.C.C. five (5) days prior to commencing well  
This card void if drilling not started within six (6) months of date received by K.C.C.

**Important procedures to follow :**

**A Regular Section of Land  
1 Mile = 5,280 Ft.**

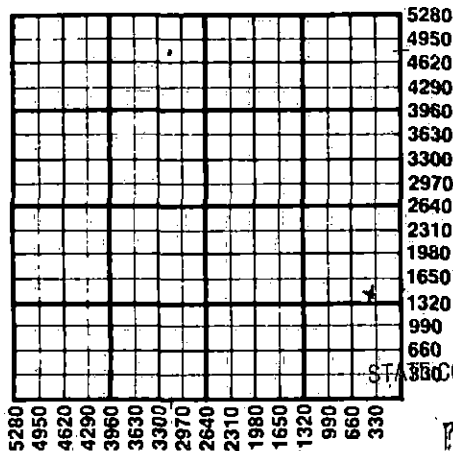

1. Notify District office before setting surface casing.
  2. Set surface casing by circulating cement to the top.
  3. File completion forms ACO-1 with K.C.C. within 90 days of well completion, following instructions on ACO-1, side 1, and including copies of wireline logs.
  4. Notify District office 48 hours prior to old well workover or re-entry.
  5. Prior to plugging, prepare a plugging plan, then obtain agreement from the appropriate district office for an approved plugging plan.
  6. Submit plugging report (CP-4) to K.C.C. after plugging is completed.
  7. Obtain an approved injection docket number before disposing of salt water.
  8. Notify K.C.C. within 10 days when injection commences or terminates.
9. Obtain appropriate 2 completion, cement in the production pipe from below any usable water to surface within 120 days of spud date.

RECEIVED  
AUG 29 1984  
8-29-84  
CONSERVATION DIVISION  
Wichita, Kansas

State Corporation Commission of Kansas  
Conservation Division  
200 Colorado Derby Building  
Wichita, Kansas 67202  
(316) 263-3238