

STATE OF KANSAS  
STATE CORPORATION COMMISSION

Give All Information Completely  
Make Required Affidavit  
Mail or Deliver Report to:  
Conservation Division  
State Corporation Commission  
211 No. Broadway  
Wichita, Kansas

WELL PLUGGING RECORD

Pratt County, Sec. 7 Twp. 28S Rge. (E) 13 (W)

Location as "NE/CNW/SW" or footage from lines Ctr. SW NW

Lease Owner GRAYBOL OIL CORPORATION

Lease Name Harris Well No. 1

Office Address 2200 Natl. Bank of Tulsa Bldg., Tulsa, Oklahoma 74103

Character of Well (completed as Oil, Gas or Dry Hole) Dry hole

Date well completed May 1 1965

Application for plugging filed May 1 1965

Application for plugging approved May 1 1965


Plugging commenced May 2 1965

Plugging completed May 2 1965

Reason for abandonment of well or producing formation

If a producing well is abandoned, date of last production 19

Was permission obtained from the Conservation Division or its agents before plugging was commenced? Yes

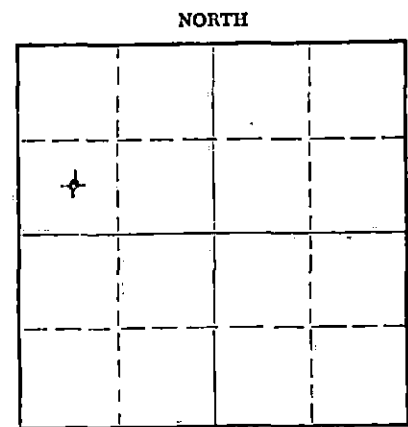

Locate well correctly on above Section Plat

Name of Conservation Agent who supervised plugging of this well Archie Elving

Producing formation None Depth to top Bottom Total Depth of Well 4483 Feet

Show depth and thickness of all water, oil and gas formations.


OIL, GAS OR WATER RECORDS

CASING RECORD

FORMATION	CONTENT	FROM	TO	SIZE	PUT IN	PULLED OUT
				8 5/8"	336'	None
Lansing Lime	Salt Water	3858	4210			
Mississippi Lime	Impermeable	4303	4342			
Viola Lime	Impermeable	4357	4402			
Simpson Sand	Impermeable and shaly	4441	4482			

Describe in detail the manner in which the well was plugged, indicating where the mud fluid was placed and the method or methods used in introducing it into the hole. If cement or other plugs were used, state the character of same and depth placed, from feet to feet for each plug set.

Filled hole with heavy mud-laden fluid to 300'. Inserted wooden plug. Placed in 1/3 sack of hulls. Cemented with 25 sacks of Portland cement. Filled hole with heavy mud-laden fluid to 40'. Placed in a wooden plug and 1/3 sack of hulls. Cemented with ten sacks of Portland cement. Placed two sacks of Portland cement in rat-hole.

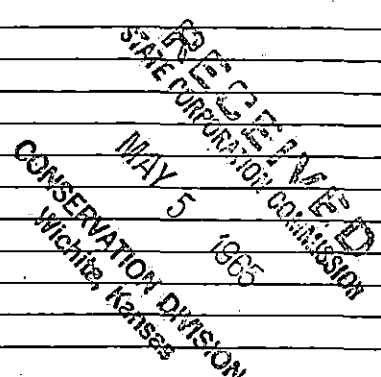

(If additional description is necessary, use BACK of this sheet)

Name of Plugging Contractor None used. Address 5-5-65

STATE OF OKLAHOMA, COUNTY OF TULSA, ss. Lyman C. Dennis (employee of owner) of the above-described well, being first duly sworn on oath, says: That I have knowledge of the facts, statements, and matters herein contained and the log of the above-described well as filed and that the same are true and correct. So help me God.

(Signature) Lyman C. Dennis  
Tulsa, Oklahoma (Address)

SUBSCRIBED AND SWORN TO before me this 3rd day of May, 1965

(Signature) Notary Public

My commission expires October 2, 1967

GRAYBOL OIL CORPORATION

Pratt County, Kansas

No. 1 Harris

Ctr. SW NW Sec. 7-28S-13W

Contractor: Company Tools

Elev. 1925 D.F., 1919 G.L.

Commenced: April 18, 1965

Completed: May 1, 1965

Production: Dry and Abandoned

RECEIVED  
STATE CORPORATION COMMISSION  
MAY 5 1965  
CONSERVATION DIVISION  
Wichita, Kansas

CASING RECORD

Set 8 5/8" casing at 336' with 225 sacks of pozmix cement.

DEPTH	FORMATION	WELEX ELECTRIC LOG STOPS:	
0-160	Surface clay	Stone Corral anhydrite	780 (+1145)
160-370	Red bed	Heebner shale	3671 (-1746)
370-770	Shale and shells	Brown lime	3841 (-1916)
770-780	Red beds	Lansing lime	3858 (-1933)
780-810	Anhydrite	Base of Kansas City	4210 (-2285)
810-1850	Shale and shells	Mississippian	4303 (-2378)
1850-1897	Shale and lime	Viola	4357 (-2432)
1897-2790	Lime and shale	Simpson shale	4421 (-2496)
2790-3160	Shale and lime	Simpson sand	4441 (-2516)
3160-3835	Lime and shale		
3835-3872	Lime	Drill Stem Test No. 1	4440-4445.
3872-4011	Lime and shale	Tool open thirty minutes. Recovered	
4011-4335	Lime	20' drilling mud. No show of oil, gas	
4335-4362	Cherty lime	or water. IBHP-1400#/30", FBHP-1273#/30"	
4362-4425	Lime and chert	IFP-31#, FFP-31#, BHT-126 <sup>o</sup> .	
4425-4445	Sandy lime and shale		
4445-4472	Shale and lime		
4472-4483	Sand and shale		

I hereby certify that the above is a true and correct log of the above-captioned well as taken directly from the daily drilling reports.

GRAYBOL OIL CORPORATION

BY: Lyman C. Dennis  
Lyman C. Dennis, Geologist

STATE OF OKLAHOMA

COUNTY OF TULSA

Subscribed and sworn to this 3rd day of May, 1965.

My Commission expires: October 2, 1967

James A. Elder  
NOTARY PUBLIC