


Give All Information Completely  
Make Required Affidavit  
Mail or Deliver Report to:  
Conservation Division  
State Corporation Commission  
P. O. Box 17027  
Wichita, Kansas 67217  
NORTH

WELL PLUGGING RECORD

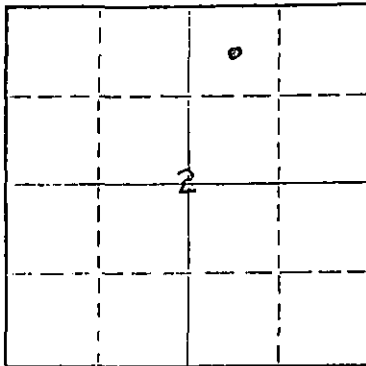

Locate well correctly on above  
Section Plat

Pratt County, Sec. 2 Twp. 28S Rge. 13 (E) (W) X  
Location as "NE/CNW&SW" or footage from lines NW NE  
Lease Owner Wm. Gruenerwald & Ass. Inc.  
Lease Name Crommer Well No. 1  
Office Address Box 909 Colorado Springs, Colo. 80901  
Character of Well (completed as Oil, Gas or Dry Hole)  
Date well completed 19  
Application for plugging filed 19  
Application for plugging approved 19  
Plugging commenced 12-6 1975  
Plugging completed 12-9 1975  
Reason for abandonment of well or producing formation  
If a producing well is abandoned, date of last production 19  
Was permission obtained from the Conservation Division or its agents before plugging was commenced? Yes

Name of Conservation Agent who supervised plugging of this well Russell Biberstein  
Producing formation Depth to top 4320 Bottom 4332 Total Depth of Well 4383  
Show depth and thickness of all water, oil and gas formations.

OIL, GAS OR WATER RECORDS

CASING RECORD

FORMATION	CONTENT	FROM	TO	SIZE	PUT IN	PULLED OUT
				13 3/8	170	none
				5 1/2	4380	3325

Describe in detail the manner in which the well was plugged, indicating where the mud fluid was placed and the method or methods used in introducing it into the hole. If cement or other plugs were used, state the character of same and depth placed, from feet to feet for each plug set.

Pump 25 sks. of cement to 4200 ft.  
Pump 2 sks. of hulls & 10 sks. of fresh gel & 150 sks. of cement from 170 ft. to 3 ft.

RECEIVED  
STATE CORPORATION COMMISSION

JAN 5 1976

1-5-76

CONSERVATION DIVISION  
Wichita, Kansas

(If additional description is necessary, use BACK of this sheet)  
Name of Plugging Contractor Sargents Casing Pulling Service Kansas No. 511  
Address Box 506 Liberal, Kansas 67901

STATE OF Colo. COUNTY OF El Paso ss.  
Jack Zimmerman (employee of owner) or (owner or operator) of the above-described

well, being first duly sworn on oath, says: That I have knowledge of the facts, statements, and matters herein contained and the log of the above-described well as filed and that the same are true and correct. So help me God.

(Signature)

*Jack Zimmerman*

SUBSCRIBED AND SWORN TO before me this 30<sup>th</sup> day of Dec., 1975

My commission expires April 12, 1977

Lois D. Jackson  
Notary Public.

# WELL LOG

15-151-20099-0000

COMPANY William Gruenerwald & Associates, Inc.

SEC. 2 T. 28S R. 13W

FARM Crommer NO. 1


LOC. NW NE

TOTAL DEPTH 4383'

COUNTY Pratt Co., Kansas

COMM. 11-7-68 COMP. 11-18-68

CONTRACTOR Garvey Drilling Company

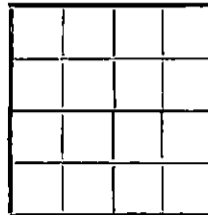

CASING 13 3/8" @ 170' w/300' sx  
5 1/2" @ 4380' w/125' sx

ELEVATION

PRODUCTION

FIGURES INDICATE BOTTOM OF FORMATIONS

- 90' Sand
- 630' Red Bed
- 697' Anhydrite
- 1130' Shale & Shells
- 1465' Red Bed & Shale
- 3385' Lime & Shale
- 3434' Lime
- 3750' Lime & Shale
- 4225' Lime
- 4303' Lime & Chert
- 4314' Shale
- 4322' Sand & Lime
- 4353' Sand
- 4363' Lime & Sand
- 4380' Sand
- 4383' Sand & Shale
- 4383' RTD

RECEIVED  
STATE CORPORATION COMMISSION

DEC 4 1975

CONSERVATION DIVISION  
Wichita, Kansas

State of Kansas }  
County of Barton } ss

I, Eunice McEachern of Garvey Drilling Company

upon oath state the above and foregoing is a true and correct copy of the log of the Crommer No. 1 well.

Subscribed and sworn to before me this 26th day of November 19 68

My Commission Expires: May 29th, 1969

Richard H. Dumber  
NOTARY PUBLIC