

STATE OF KANSAS
STATE CORPORATION COMMISSION

WELL PLUGGING RECORD

Give All Information Completely
Make Required Affidavit
Mail or Deliver Report to
Conservation Division
State Corporation Comm.
245 North Water
Wichita, KS 67202

Kingman County. Sec. 31 Twp. 28S Rge. 10W E/W
Location as "NE/CNW $\frac{1}{4}$ /SW $\frac{1}{4}$ " or footage from lines _____

NW NW SE
Lease Owner Mid-Continent Energy Corporation
Lease Name Fenn Well No. 1

Office Address Box 18148, Wichita, Kansas 67202

Character of Well (Completed as Oil, Gas or Dry Hole) _____
Dry Hole

Date Well completed January 22, 1978

Application for plugging filed January 21, 1978

Application for plugging approved January 21, 1978

Plugging commenced January 22, 1978

Plugging completed January 22, 1978

Reason for abandonment of well or producing formation _____

Dry


If a producing well is abandoned, date of last production _____
19 _____

Was permission obtained from the Conservation Division or its agents before plugging was commenced? Yes

Name of Conservation Agent who supervised plugging of this well Dwayne Rankin

Producing formation _____ Depth to top _____ Bottom _____ Total Depth of Well _____

Show depth and thickness of all water, oil and gas formations.

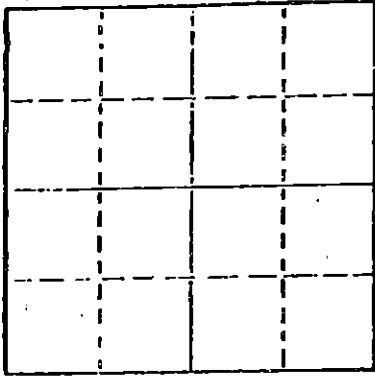

Locate well correctly on above Section Plot

OIL, GAS OR WATER RECORDS

CASING RECORD

STATE	FORMATION	CONTENT	FROM	TO	SIZE	PUR IN	PULLED OUT
			0	215	8 5/8"	208.87	None

JAN 31 1978
1-31-78
CONSERVATION DIVISION
Wichita, Kansas

Describe in detail the manner in which the well was plugged, indicating where the mud fluid was placed and the method or methods used in introducing it into the hold. If cement or other plugs were used, state the character of same and depth placed, from _____ feet to _____ feet for each plug set.

Plugged:
40 sacks @ 540, 20 sacks @ 300,
Mud to 40', Plugged 1/2 sack hulls
12 sacks to base. 2 sacks in mousehole
2 sacks in rathole. Completed by
Halliburton @ 2:30 AM

(If additional description is necessary, use BACK of this sheet)

Name of Plugging Contractor DaMac Drilling Inc.
Box 1164, Great Bend, Kansas 67530

STATE OF Kansas COUNTY OF Barton ss.

Martha J. McKown (employee of owner) or (owner or operator) of the above-described well, being first duly sworn on oath, says: That I have knowledge of the facts, statements, and matters herein contained and the log of the above-described well as filed and that the same are true and correct. So help me God.

(Signature) Martha J. McKown
Box 1164, Great Bend, Kansas 67530
(Address)

SUBSCRIBED AND SWORN TO before me this 25th day of January, 1978

My commission expires 4-28-81

Lana L. Remmert
Notary Public

STATE NOTARY PUBLIC
LANA L. REMMERT
Barton County, Kansas
My Appt. Exp. 4-28-81

WELL LOG

15-69-20676-0000

COMPANY Mid-Continent Energy Corp.

SEC. 31 T. 28S R. 10W

FARM Fenn NO. 1


LOC. NW NW SE

TOTAL DEPTH 4740'

COUNTY Kingman

COMM. 1-13-78 COMP. 1-22-78

CONTRACTOR DaMac Drilling Inc.

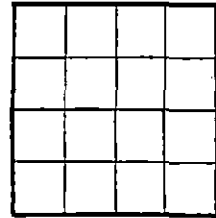

CASING 8 5/8' set @ 215'

ELEVATION

PRODUCTION

FIGURES INDICATE BOTTOM OF FORMATIONS

0	215	Surface Sand, Clay, Shells
215	690	Shale, RedBed
690	1870	Shale
1870	3770	Lime, Shale
3770	4740 RTD	Lime

RECEIVED
STATE CORPORATION COMMISSION
JAN 31 1978
CONSERVATION DIVISION
Wichita, Kansas

State of Kansas }
County of Barton } SS

I, Martha J. McKown of DaMac Drilling Inc.

upon oath state the above and foregoing is a true and correct copy of the log of the Fenn No. 1 well.

Martha J. McKown

Subscribed and sworn to before me this 25th day of January 19 78

My Commission Expires: 4-28-81

Lana L. Remmert
NOTARY PUBLIC

