

Give All Information Completely
Make Required Affidavit
Mail or Deliver Report to:
Conservation Division
State Corporation Commission
211 No. Broadway
Wichita, Kansas

WELL PLUGGING RECORD

Kingman County, Sec. 2 Twp. 28s Rge. 10 (E) X (W)

Location as "NE/CNW/SW" or footage from lines C NW NW

Lease Owner German Drilling Company

Lease Name Cooley Estate Well No. 1

Office Address 608 Petroleum Building, Wichita 2, Kansas

Character of Well (completed as Oil, Gas or Dry Hole) Dry Hole

Date well completed 2-9--63 19

Application for plugging filed 2-9--63 19

Application for plugging approved 2-9--63 19


Plugging commenced 2-9-63 19

Plugging completed 2-9-63 19

Reason for abandonment of well or producing formation Dry Hole

If a producing well is abandoned, date of last production _____ 19

Was permission obtained from the Conservation Division or its agents before plugging was commenced? Yes

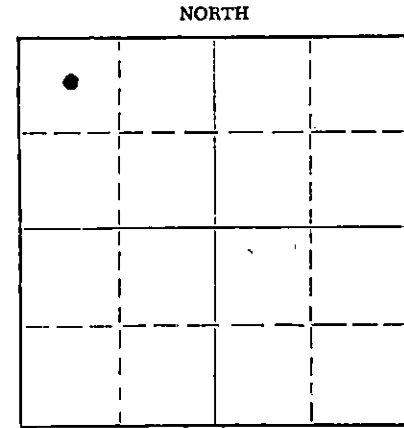

Locate well correctly on above Section Plat

Name of Conservation Agent who supervised plugging of this well Archie Eluing

Producing formation _____ Depth to top _____ Bottom _____ Total Depth of Well _____ Feet

Show depth and thickness of all water, oil and gas formations.

OIL, GAS OR WATER RECORDS

CASING RECORD

FORMATION	CONTENT	FROM	TO	SIZE	PUT IN	PULLED OUT

Describe in detail the manner in which the well was plugged, indicating where the mud fluid was placed and the method or methods used in introducing it into the hole. If cement or other plugs were used, state the character of same and depth placed, from 4489 feet to 180 feet for each plug set.

Mud from total depth to 180'-- $\frac{1}{4}$ sk. hulls and plug and 20 sks. cement--
Mud to 40' and $\frac{1}{4}$ sk. hulls, plug and 8 sks. cement--2 sks. in rathole.

RECEIVED
STATE CORPORATION COMMISSION

FEB 12 1963
2-12-63
CONSERVATION DIVISION
Wichita, Kansas

(If additional description is necessary, use BACK of this sheet)

Name of Plugging Contractor German Drilling Company

Address 608 Petroleum Building, Wichita, Kansas

STATE OF KANSAS, COUNTY OF BUTLER, ss.
Harvey F. German (Employee of owner) or (owner or operator) of the above-described

well, being first duly sworn on oath, says: That I have knowledge of the facts, statements, and matters herein contained and the log of the above-described well as filed and that the same are true and correct. So help me God.

(Signature) Harvey F. German
608 Petroleum Building, Wichita 2, Kansas
(Address)

SUBSCRIBED AND SWORN TO before me this 11th day of February, 19, 63

My commission expires December 29th, 1963.
Geneva M. German Notary Public.

WELL LOG - Cooley Estate #1

OPERATOR: German Drilling Company
608 Petroleum Building
Wichita 2, Kansas

LOCATION: C NW NW
Sec. 2-28s-10w
Kingman County
Kansas

CONTRACTOR: German Drilling Company
608 Petroleum Building
Wichita 2, Kansas

Farm: Cooley Estate - Well No. 1
Date Commenced: 1-28-63
Date Completed: 2-9-63 - Rotary

From	To	Formation
0	80	Sand
80	245	Red rock and lime
245	650	Red rock
650	1310	Red rock and shale
1310	1375	Lime and shale
1375	1655	Lime and shale
1655	1855	Lime and shale
1855	2033	Lime
2033	2360	Lime and shale
2360	2560	Shale and lime
2560	2690	Lime and shale
2690	2850	Lime and shale
2850	2886	Lime and shale
2886	3026	Shale and lime
3026	3108	Lime and shale
3108	3275	Lime and shale
3275	3352	Lime and shale
3352	3415	Sand (Douglas-3352)
3415	3468	Shale and sand
3468	3505	Lime (Brown Lime-3468) (Lansing-3499)
3505	3603	Lime
3603	3667	Lime
3667	3720	Lime
3720	3780	Lime
3780	3850	Lime
3850	3925	Lime
3925	4036	Lime (Mississippi-4016)
4036	4056	Lime
4056	4077	Chert and lime
4077	4085	Chert and lime
4085	4112	Shale (Kinderhook-4085)
4112	4207	Shale
4207	4295	Shale
4295	4305	Lime and shale (Viola-4294)
4305	4334	Lime
4334	4362	Lime
4362	4380	Sand (Simpson-4368)
4380	4415	Sand and shale
4415	4444	Shale
4444	4465	Shale
4465	4487	Lime (Arbuckle-4465)
4487	4489	Lime
4489		Total Depth

STATE CORPORATION COMMISSION
FEB 12 1963
CONSERVATION DIVISION
Wichita, Kansas

I hereby certify that the foregoing is a true and correct copy of the Well Log for the Cooley Estate #1, drilled for German Drilling Company, and completed February 9th, 1963.

GERMAN DRILLING COMPANY

STATE OF KANSAS)
COUNTY OF BUTLER)

ss.

Harvey F. German
Harvey F. German--Owner

SUBSCRIBED AND SWORN to, before the undersigned a Notary Public, in and for County and State aforesaid this eleventh day of February, 1963.

Geneva M. German
Geneva M. German-Notary Public

My Commission expires 12-29-63.