

STATE OF KANSAS
STATE CORPORATION COMMISSION


WELL PLUGGING RECORD

15-095-21030-0600

Give All Information Completely
Make Required Affidavit
Mail or Deliver Report to
Conservation Division
State Corporation Comm.
245 North Water
Wichita, KS 67202

Kingman County, Sec. 29 Twp. 28S Rge. 9W E/W
Location as "NE/CNW/SW" or footage from lines
C-N/2 N/2 NW

Lease Owner Gemini Oil Company
Lease Name Swander Well No. 1
Office Address 1408 Philtower Bldg., Tulsa, OK 74103
Character of Well (Completed as Oil, Gas or Dry Hole)
Dry Hole

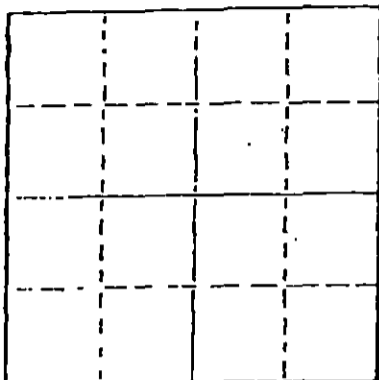

Locate well correctly on above
Section Plot

Date Well completed December 1, 1980
Application for plugging filed Verbal Application 19
Application for plugging approved Verbal Approval 19
Plugging commenced December 1, 1980
Plugging completed December 1, 1980
Reason for abandonment of well or producing formation

If a producing well is abandoned, date of last production 19

Was permission obtained from the Conservation Division or
its agents before plugging was commenced? Yes

Name of Conservation Agent who supervised plugging of this well Duane L. Rankin
Producing formation Depth to top Bottom Total Depth of Well 2,650
Show depth and thickness of all water, oil and gas formations.

OIL, GAS OR WATER RECORDS

CASING RECORD

FORMATION	CONTENT	FROM	TO	SIZE	PUT IN	PULLED OUT
				8-5/8"	293'	None

Describe in detail the manner in which the well was plugged, indicating where the mud fluid
was placed and the method or methods used in introducing it into the hold. If cement or other
plugs were used, state the character of same and depth placed, from feet to
feet for each plug set.

Filled hole with heavy rotary mud from 2,650 ft. (rotary total depth) to
340 ft. Set plug at 340 ft. and cemented with 40 sacks cement. Filled hole
with heavy rotary mud from 340 ft. to 40 ft. Set solid plug at 40 ft. and
cemented to cellar with 10 sacks cement, 5 sacks cement in rat hole.

Plugging operations accomplished utilizing Halliburton Services Oil Well
cementing pump truck through 4 1/2 inch drill pipe.

(If additional description is necessary, use BACK of this sheet)

Name of Plugging Contractor Halliburton Services
410 Union Center Bldg., Wichita, Kansas 67202

STATE OF Kansas COUNTY OF Sedgwick
Dean Britting, Agent

I, the above-described well, being first duly sworn on oath, says: That I have knowledge of
the facts, statements, and matters herein contained and the log of the above-described well
is filed and that the same are true and correct. So help me God.

(Signature) Dean Britting
251 N. Water-Suite 10, Wichita, KS 67202
(Address)

SUBSCRIBED AND SWORN TO before me this 15th day of December, 1980

My commission expires July 25, 1982

Elsie Willison - Notary Public.

KANSAS DRILLERS LOG

COMPANY Gemini Oil Company

SEC. 29 T. 28S. 9W

FARM Swander NO. 1

LOC. C-N/2 N/2 NW

COUNTY Kingman

ROTARY TOTAL DEPTH 2,650'

COMM. November 26, 1980 COMP. December 1, 1980

CONTRACTOR H-30, INC. (Rig #3)

ISSUED December 15, 1980

CASING

10 3/4"

8 5/8" Set at 293' cemented w/275 sxs cement

ELEVATION 1,715' K.B.

5 1/2"

4 1/2"

FIGURES INDICATE BOTTOM OF FORMATIONS

Sand	100'
Sand and Red Bed	294'
Shale and Shells	555'
Shale	1,406'
Lime and Shale	1,460'
Shale and Lime	1,723'
Lime and Shale	2,650'
Rotary Total Depth	2,650'

I hereby certify the above and foregoing to be a true and correct log of the above described well as shown by the drilling reports.

H-30, INC.

Dean Britting

 Dean Britting

State of Kansas)
) ss:
 County of Sedgwick)

Subscribed and Sworn to before me a Notary Public in and for said county and state this 15th day of December, 1980.

Elsie Willison

 Elsie Willison - Notary Public

My Commission Expires:

July 25, 1982

DISTRICT WATTI, KS.

DATE 7/25/82

TO: HALLIBURTON SERVICES YOU ARE HEREBY REQUESTED TO FURNISH EQUIPMENT AND SERVICEMEN TO DELIVER AND OPERATE

THE SAME AS AN INDEPENDENT CONTRACTOR TO: Corwin Oil Co. (CUSTOMER) AND DELIVER AND SELL PRODUCTS, SUPPLIES, AND MATERIALS FOR THE PURPOSE OF SERVICING

WELL NO. 2 LEASE Mr. Kanna SEC. 29 TWP. 28 RANGE 9W

FIELD _____ COUNTY Keosauqua STATE Kansas OWNED BY Same

THE FOLLOWING INFORMATION WAS FURNISHED BY THE CUSTOMER OR HIS AGENT

FORMATION NAME	TYPE	NEW USED	WEIGHT	SIZE	FROM	TO	MAX. ALLOW. P.S.I.
CASING		U	24 1/2	8 3/4"	KB	427'	
LINER							
TUBING		U	16 6/8	4 1/2"	KB	400'	
OPEN HOLE							SHOTS/FT.
PERFORATIONS							
PERFORATIONS							
PERFORATIONS							

PREVIOUS TREATMENT: DATE _____ TYPE _____ MATERIALS _____

TREATMENT INSTRUCTIONS: TREAT THRU TUBING ANNULUS CASING TUBING/ANNULUS HYDRAULIC HORSEPOWER ORDERED
plug & abandon with 70 sacks 20/60 permin containing 4% gel
50 sk at 400'
10 sk at 40'
10 sk in Kalkale

CUSTOMER OR HIS AGENT WARRANTS THE WELL IS IN PROPER CONDITION TO RECEIVE THE PRODUCTS, SUPPLIES, MATERIALS, AND SERVICES

THIS CONTRACT MUST BE SIGNED BEFORE WORK IS COMMENCED

- As consideration, the above-named Customer agrees:
- (a) To pay Halliburton in accord with the rates and terms stated in Halliburton's current price lists.
 - (b) Halliburton shall not be responsible for and Customer shall secure Halliburton against any liability for damage to property of Customer and of the well owner (if different from Customer), unless caused by the willful misconduct or gross negligence of Halliburton, this provision applying to but not limited to subsurface damage and surface damage arising from subsurface damage.
 - (c) Customer shall be responsible for and secure Halliburton against any liability for reservoir loss or damage, or property damage resulting from subsurface pressure, losing control of the well and/or a well blowout, unless such loss or damage is caused by the willful misconduct or gross negligence of Halliburton.
 - (d) Customer shall be responsible for and secure Halliburton against any and all liability of whatsoever nature for damages as a result of subsurface trespass, or an action in the nature thereof, arising from a service operation performed by Halliburton hereunder.
 - (e) Customer shall be responsible for and secure Halliburton against any liability for injury to or death of persons, other than employees of Halliburton, or damage to property (including, but not limited to, injury to the well), or any damages whatsoever, irrespective of cause, growing out of or in any way connected with the use of radioactive material in the well hole, unless such damage shall be caused by the willful misconduct or gross negligence of Halliburton.
 - (f) Halliburton makes no guarantee of the effectiveness of the products, supplies or materials, nor of the results of any treatment or service.
 - (g) Customer shall, at its risk and expense, attempt to recover any Halliburton equipment, tools or instruments which are lost in the well and if such equipment, tools or instruments are not recovered, Customer shall pay Halliburton its replacement cost unless such loss is due to the sole negligence of Halliburton. If Halliburton equipment, tools or instruments are damaged in the well, Customer shall pay Halliburton the lesser of its replacement cost or the cost of repairs unless such damage is caused by the sole negligence of Halliburton. In the case of equipment, tools or instruments for marine operations, Customer shall, in addition to the foregoing, be fully responsible for loss of or damage to any of Halliburton's equipment, tools or instruments which occurs at any time after delivery to Customer at the landing until returned to the landing, unless such loss or damage is caused by the sole negligence of Halliburton.
 - (h) Because of the uncertainty of variable well conditions and the necessity of relying on facts and supporting services furnished by others, Halliburton is unable to guarantee the accuracy of any chart interpretation, research analysis, job recommendation or other data furnished by Halliburton. Halliburton personnel will use their best efforts in gathering such information and their best judgment in interpreting it, but Customer agrees that Halliburton shall not be responsible for any damages arising from the use of such information except where due to Halliburton's gross negligence or willful misconduct in the preparation or furnishing of it.
 - (i) Halliburton warrants only title to the products, supplies and materials and that the same are free from defects in workmanship and materials. THERE ARE NO WARRANTIES, EXPRESS OR IMPLIED, OF MERCHANTABILITY, FITNESS OR OTHERWISE WHICH EXTEND BEYOND THOSE STATED IN THE IMMEDIATELY PRECEDING SENTENCE. Halliburton's liability and Customer's exclusive remedy in any cause of action (whether in contract, tort, breach of warranty or otherwise) arising out of the sale or use of any products, supplies or materials is expressly limited to the replacement of such products, supplies or materials on their return to Halliburton or, at Halliburton's option, to the allowance to the Customer of credit for the cost of such items. In no event shall Halliburton be liable for special, incidental, indirect, punitive or consequential damages.
 - (j) Upon Customer's default in payment of Customer's account by the last day of the month following the month in which the invoice is dated, Customer agrees to pay interest thereon after default at the highest lawful contract rate applicable but never to exceed 18% per annum. In the event it becomes necessary to employ an attorney to enforce collection of said account, Customer agrees to pay all collection costs and attorney fees in the amount of 20% of the amount of the unpaid account.
 - (k) This contract shall be governed by the law of the state where services are performed or equipment or materials are furnished.
 - (l) Halliburton shall not be bound by any changes or modifications in this contract, except where such change or modification is made in writing by a duly authorized executive officer of Halliburton.

I HAVE READ AND UNDERSTAND THIS CONTRACT AND REPRESENT THAT I AM AUTHORIZED TO SIGN THE SAME AS CUSTOMER'S AGENT.

SIGNED Roll Wilson CUSTOMER

DATE 7/25/82

TIME 12:30 A.M. P.M.

We certify that the Fair Labor Standards Act of 1938, as amended, has been complied with in the production of goods and/or with respect to services furnished under this contract.

CUSTOMER

*Mustang Drilling Exploration, Inc
P.O. Draw # 1609
Grant Bend Kansas 67530*

*orders by G. Toman
Turned in by Maurice Lester*

RECEIVED STATE CORPORATION COMMISSION

AUG 09 1982

AUG 09 1982

CONSERVATION DIVISION
Wichita, Kansas

CONSERVATION DIVISION
Wichita, Kansas