


STATE OF KANSAS
STATE CORPORATION COMMISSION

15-045-20361-0000

WELL PLUGGING RECORD

Give All Information Completely
Make Required Affidavit
Mail or Deliver Report to
Conservation Division
State Corporation Comm.
245 North Water
Wichita, KS 67202

Kingman County. Sec. 20 Twp. 28S Rge. 9W E/W
Location as "NE/CNW $\frac{1}{4}$ SW $\frac{1}{4}$ " or footage from lines
100'-W NE NE SW
Lease Owner Jay C. Clark
Lease Name Swander #1 Well No.
Office Address 245 South Terrace, Wichita, Kansas 67218
Character of Well (Completed as Oil, Gas or Dry Hole)

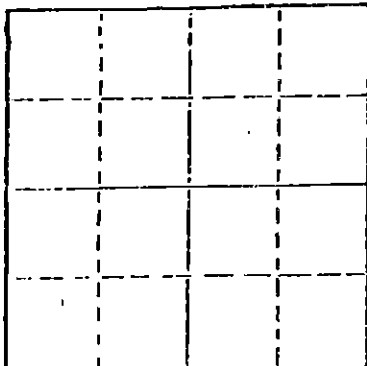

Locate well correctly on above
Section Plat

Date Well completed 19
Application for plugging filed 19
Application for plugging approved 19
Plugging commenced 10/10/80 19
Plugging completed 10/10/80 19
Reason for abandonment of well or producing formation
Depleted

If a producing well is abandoned, date of last production 19.

Was permission obtained from the Conservation Division or
its agents before plugging was commenced? Yes

Name of Conservation Agent who supervised plugging of this well Bill Owen
Producing formation Depth to top Bottom Total Depth of Well 4420'
Show depth and thickness of all water, oil and gas formations.

OIL, GAS OR WATER RECORDS

CASING RECORD

FORMATION	CONTENT	FROM	TO	SIZE	PUT IN	PULLED OUT
				8-5/8"	340	None
				4-1/2"	4418	3539'

Describe in detail the manner in which the well was plugged, indicating where the mud fluid
was placed and the method or methods used in introducing it into the hold. If cement or other
plugs were used, state the character of same and depth placed, from feet to
feet for each plug-set.

Squeezed hole with 15 sacks gel, 8 sacks hulls and 10 sacks gel.
Released plug and displaced with 125 sacks 50/50 pos, 4% gel, 3% cc.
Plugging complete.

10-15-80

(If additional description is necessary, use BACK of this sheet)

Name of Plugging Contractor KELSO CASING PULLING
CHASE, KANSAS

STATE OF Kansas COUNTY OF Rice
R. Darrell Kelso (employee of owner) or (owner/operator)

of the above-described well, being first duly sworn on oath, says: That I have known the
facts, statements, and matters herein contained and the log of the above-described well
as filed and that the same are true and correct. So help me God.

(Signature) R. Darrell Kelso
Chase, Kansas (Address)

SUBSCRIBED AND SWORN TO before me this 14th day of October, 19 80



Joan Kelso
Notary Public.



RECEIVED
STATE CORPORATION COMMISSION
OCT 15 1980
Wichita, Kansas

15-095-20361-0000

DEFENDANT'S EXHIBIT
No. *N*

GREAT GUNS

R. C. [unclear]

FILE NO.

Field Print

COMPANY *Paxco. Inc.*

WELL Swander #1

FIELD Par Creek north


LOCATION: *100' W - NE - NE - SW*

OTHER SERVICES

SEC. *2* TWP *28* RGE *9*

Permanent Datum *Ground Level* Elev. *1119*

Log Measured from *Kelly Bushing* Ft. Above Perm. at Datum

Drilling Measured from *Kelly Bushing*

Elevations:

KE *1227*

DF *1224*

GL *1219*

Date	Gamma	Neutron	Sicard	Caliper
<i>5-9-75</i>	<i>Gamma</i>	<i>Neutron</i>	<i>Sicard</i>	<i>Caliper</i>
Run No.	<i>310</i>	<i>310</i>	<i>310</i>	<i>310</i>
Depth-Driller	<i>4720</i>	<i>4720</i>	<i>4720</i>	<i>4720</i>
Depth-Larger	<i>4718</i>	<i>4718</i>	<i>4718</i>	<i>4718</i>
Bottom Logged Interval	<i>4718</i>	<i>4718</i>	<i>4718</i>	<i>4718</i>
Top Logged Interval	<i>200</i>	<i>200</i>	<i>4714</i>	<i>4707</i>
Casing - Driller	<i>328 @ 344</i>	<i>200</i>	<i>1500</i>	<i>1500</i>
Casing - Logger		<i>0</i>	<i>0</i>	<i>0</i>
Bit Size	<i>7 3/8</i>			
Type Fluid in Hole	<i>Drilling Mud</i>			
Density and Viscosity	<i>10.1 41</i>			
pH and Fluid Loss	<i>6.2 12.4 cc</i>			
Source of Sample	<i>7-12 4100</i>			
Rm @ Mean Temp.	<i>.03 @ 75 °F</i>			
Rm @ Mean Temp.	<i>.02 @ 75 °F</i>			
Rm @ Mean Temp.	<i>.12 @ 75 °F</i>			
Source of Rm and Rm	<i>12775</i>			
Rm @ BIT	<i>.05 @ 115 °F</i>			
Th @ Since Circ	<i>2 1205</i>			
Max. Rec. Temp. Deg. F	<i>110 °F</i>			
Radio. No. and Location	<i>2 1205</i>			
Recorded By	<i>HAYS</i>			
Checked By	<i>2 1205</i>			

RECEIVED
STATE CORPORATION COMMISSION
OCT - 3 1980
CONSERVATION DIVISION
Wichita, Kansas