

15-095-00217-0000

WELL PLUGGING RECORD


FORMATION PLUGGING RECORD

STATE OF KANSAS
STATE CORPORATION COMMISSION
All Information Completely
Also, Required Affidavit
Mail or Deliver Report to:
Conservation Division
State Corporation Commission
800 Bitting Building
Wichita, Kansas

Strike out upper line
when reporting plug-
ging of formations.

KINGMAN County Sec. 20 Twp. 28 Rge. (E) 9 (W)

Location as "NE1/4NW1/4SW1/4" or footage from lines SW/4 - SE/4 - SW/4
Lease Owner NEBRASKA - WYOMING OIL CO.
Lease Name SWANDER Well No. 1
Office Address Box 273 Stafford, Kansas
Character of Well (completed as Oil, Gas or Dry Hole) Oil
Date well completed January 7 19 47
Application for plugging filed March 23 19 55
Application for plugging approved March 28 19 55
Plugging commenced June 21 19 55
Plugging completed July 7 19 55
Reason for abandonment of well or producing formation Exhausted

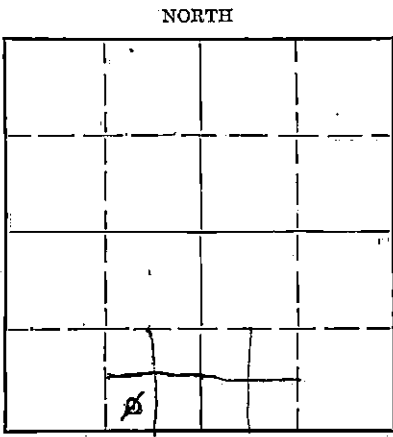

Locate well correctly on above
Section Plat

If a producing well is abandoned, date of last production March 19 54
Was permission obtained from the Conservation Division or its agents before plugging was com-
menced? Yes

Name of Conservation Agent who supervised plugging of this well M. A. Rives
Producing formation VIOLA Depth to top 4406' Bottom 4449' Total Depth of Well 4569 Feet
Show depth and thickness of all water, oil and gas formations.

OIL, GAS OR WATER RECORDS

CASING RECORD

Table with 7 columns: Formation, Content, From, To, Size, Put In, Pulled Out. Contains data for 10 3/4" and 5 1/2" casing sizes.

Describe in detail the manner in which the well was plugged, indicating where the mud fluid was placed and the method or methods used in
introducing it into the hole. If cement or other plugs were used, state the character of same and depth placed, from... feet to
... feet for each plug set.

Plugged back w/ sand to 4120'
Dumped 5 sks. of cement w/ Bailer
Circulated mud w/ Halliburton Truck through 5 1/2"
Pulled 5 1/2" casing
Mudded hole to 250' below base of cellar
Set 5' rock bridge at 250'
Mudded hole to 30' below base of cellar
Set 5' rock bridge at 30'
Mixed & poured 10 sks. of cement. Filled to base of cellar

(If additional description is necessary, use BACK of this sheet)

Correspondence regarding this well should be addressed to NEBRASKA - WYOMING OIL CO.
Address Box 273 Stafford, Kansas


STATE OF KANSAS COUNTY OF STAFFORD
I, E. E. Duncan (employee of owner) or (owner/operator) of the above-described well,

being first duly sworn on oath, says: That I have knowledge of the facts, statements, and matters herein contained and the log of the above-
described well as filed and that the same are true and correct. So help me God.

(Signature) by: E. E. Duncan
E. E. Duncan, Prod. Supt.
Box 273 Stafford, Kansas
(Address)

SUBSCRIBED AND SWORN to before me this 16 day of July 19 55

My commission expires August 4, 1958

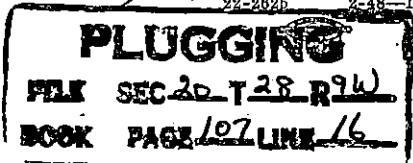

RECEIVED Notary Public.
STATE CORPORATION COMMISSION
JUL 13 1955 7-18-55
CONSERVATION DIVISION
Wichita, Kansas

15-095-00217-0000

PLAINS EXPLORATION COMPANY

Swander # 1.

Drillers Well Log

CONTRACTOR --- STERLING DRILLING COMPANY
COMMENCED --- 11-27-46
SHOT OR TREATED -- NO ACID
PRODUCTION --- 1604 Bbl. BOMB POT.
TOTAL DEPTH --- 4569
COMPLETED --- JAN. 7, 1947

SEC. 20 - T. 28S - R. 9W
LOC. SW₂ - SE₂ - SW₂
COUNTY -- KINGMAN
ELEVATION 1778 KB

ALL MEASUREMENTS FROM KELLY BUSHING.

CASING RECORD

10 3/4" at 265 Cemented with 150 sks.
5 1/2" at 4558 Cemented with 200 sks.

0' Kelly Bushing
120' Sand
250' Shale & Red Bed
300' Red Bed
350' Shale
4516' Shale Shells
1650' Lime & Shale
1960' Shale & Shells
2335' Broken Lime
2745' Shale & Shells
3435' Lime
3520' Lime & Shale
3960' Lime
4115' Lime & Shale
4129' Shale
4240' Lims
4406' Shale
4465' Lime
4505' Sandy Shale & Lime
4558' Shale
4560' Lims
R.T.D.
4569' Lime
Cable Tools T.D.

GEOLOGISTS TOPS

Lansing K.C. 3663
Soft Zone - 3942' - 48' No Show.
Miss. Chot. 4129' Porosity Good Stain
Drill Stem Test. Tool Open 30 mi. 20' Mud.
No Show of Oil.
Kind erhook 4203'
Viola Top 4406'. Fair Porosity Fair
Stain from 4406' - 18' Drill Stem Test.
Tool Open 30 mi. From 4406' to 4412'
Flowed Live Oil in Pit in 28 mi.
Simpson Sh. 4449' Sandy Zone Light Stain
4516' Arbuckle 4558' Dense Dolomite.
Rotary Total Depth. Fill up 75' Per
Hour with Water No Show of Oil after
Drilling from 4562' - 65' with Cable
Tools. Drilled to 4569' with increase
of water T.D. 4569'.
Lime Wells Plug Set at 4459'. 11 Holes
in Pipe by Lane Well from 4407' to
4411'. Well flowed 38 Bbls. Per Hrs.
3 hrs. Test Dec. 31, 1946 State,
Potential with Bomb 1604 Bbls. The
1st and 31st 1947.

I HEREBY CERTIFY THE ABOVE RECORD IS A TRUE AND CORRECT RECORD OF THE
DRILLERS LOG ON THIS WELL.

SIGNED *E. S. Duncan*

SUBSCRIBED AND SWORN TO BEFORE ME THIS 8th DAY OF February 1947
MY COMMISSION EXPIRES July 24 1948

Helma W. Bushing
NOTARY PUBLIC

PLUGGING
SEC 20 T28 R9W
DATE OCT 27 1946