


All Information Completely
Make Required Affidavit
Mail or Deliver Report to:
Conservation Division
State Corporation Commission
211 No. Broadway
Wichita, Kansas

WELL PLUGGING RECORD

NORTH

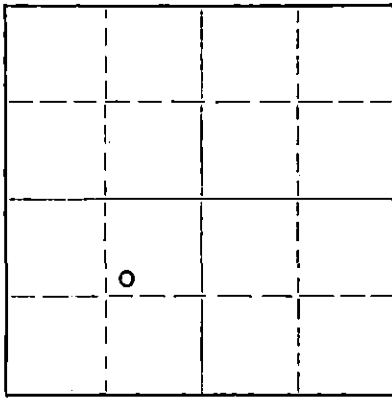

Locate well correctly on above
Section Plat

Kingman County. Sec. 10 Twp 28S Rge. 6 (E) (W)
Location as "NE/CNWKSW" or footage from lines C SW NE SW
Lease Owner Eldorado Refining Company
Lease Name Scheuman Well No. 1
Office Address 306 Koch Bldg., Wichita, Kansas
Character of Well (completed as Oil, Gas or Dry Hole) Dry Hole
Date well completed June 21 19 56
Application for plugging filed June 21 19 56
Application for plugging approved June 21 19 56
Plugging commenced June 21 19 56
Plugging completed June 21 19 56
Reason for abandonment of well or producing formation
Dry hole
If a producing well is abandoned, date of last production _____ 19 ____
Was permission obtained from the Conservation Division or its agents before plugging was commenced? Yes, orally

Name of Conservation Agent who supervised plugging of this well _____
Producing formation None Depth to top _____ Bottom _____ Total Depth of Well 4411 Feet
Show depth and thickness of all water, oil and gas formations.

OIL, GAS OR WATER RECORDS

CASING RECORD

FORMATION	CONTENT	FROM	TO	SIZE	PUT IN	PULLED OUT
Surface		0	222	8 5/8"	222	None

Describe in detail the manner in which the well was plugged, indicating where the mud fluid was placed and the method or methods used in introducing it into the hole. If cement or other plugs were used, state the character of same and depth placed, from _____ feet to _____ feet for each plug set.

Filled hole with heavy mud, set plug at 222' with 20 sax cement & hulls.
Filled hole with heavy mud to 258, set plug with 5 sax cement & hulls.
Leveled location.

(If additional description is necessary, use BACK of this sheet)

Name of Plugging Contractor Ben F. Brack Oil Co., Inc.
Address 310 Brown Bldg, Wichita, Kansas

STATE OF Kansas, COUNTY OF Sedgwick, ss.
Emil E. Bowers (employee of owner) or (owner or operator) of the above-described well, being first duly sworn on oath, says: That I have knowledge of the facts, statements, and matters herein contained and the log of the above-described well as filed and that the same are true and correct. So help me God.

(Signature) Emil E. Bowers
310 Brown Bldg., Wichita, Kansas (Address)

SUBSCRIBED AND SWORN TO before me this 25th day of June, 1956
Diane Oak Lawton Notary Public.

My commission expires Jan. 27, 1960

PLUGGING
FILE SEC. 10 T. 28 R. 6W
BOOK PAGE 73 LINE 38

6-26-56

15-095-00208-0000

BEN F. BRACK OIL COMPANY, INC.
310 BROWN BUILDING
WICHITA, KANSAS

SCHEUMAN #1

SW NE SW

Sec. 10-28S-6W
Kingman County, Ks.
Commenced: 5-31-56
Completed: 6-21-56

TOTAL DEPTH: 4411'
Elevation:

W E L L L O G

Red rock & Shale	0	-	55
Sand			90
Shale & Shells			223
Red bed & shale			715
Shale			840
Salt-Shale			990
Shale & Lime			1170
Lime & Shale			1350
Shale & Lime			1470
Shale & Lime			1580
Lime & Shale			1750
Shale & Lime			2100
Lime & Shale			2985
Sandy Shale			3028
Lime & Shale			3179
Lime			3288
Lime & Shale			3361
Lime			3376
Lime & Shale			3399
Lime			3727
Lime & Shale			3837
Shale & Lime			3855
Lime			4209
Lime & Shale			4273
Lime, sand & shale			4317
Lime & Shale			4337
Lime & Shale			4369
Lime			4411 TD

CASING

222' of 8 5/8" Csg.

The above depths denote bottom of formations.

To the best of my knowledge,
the above is a true and
correct statement of the
depths and formations and
where found.

BEN F. BRACK OIL COMPANY, INC.

By Emil E. Bowen

Witnessed:

Gertrude A. Crut

April 25, 1956

STATE OF KANSAS
JUN 26 1956
CONSERVATION DIVISION
Wichita, Kansas

PLUGGING
FILE SEC 10 T 28 R6W
BOOK PAGE 73 LINE 38