


STATE OF KANSAS
STATE CORPORATION COMMISSION

WELL PLUGGING RECORD

Give All Information Completely
Make Required Affidavit
Mail or Deliver Report to
Conservation Division
State Corporation Comm.
245 North Water
Wichita, KS 67202

Pratt County, Sec. 26 Twp. 28 Rge. 13 E/W
Location as "NE/CNW $\frac{1}{4}$ SW $\frac{1}{4}$ " or footage from lines
SW/NW/NW
Lease Owner Continental Oil Company
Lease Name ED BREHM Well No. 3
Office Address Box 267, Great Bend, Kansas 67530
Character of Well (Completed as Oil, Gas or Dry Hole)

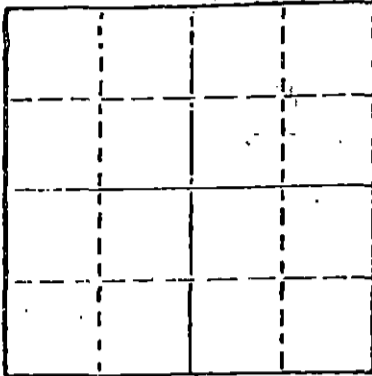

Locate well correctly on above
Section Plot

Date Well completed 19
Application for plugging filed 19
Application for plugging approved 19
Plugging commenced April 7 19 77
Plugging completed April 26 19 77
Reason for abandonment of well or producing formation
depleted
If a producing well is abandoned, date of last production 19

Was permission obtained from the Conservation Division or
its agents before plugging was commenced? yes

Name of Conservation Agent who supervised plugging of this well Jasper Metz
Producing formation Depth to top Bottom Total Depth of Well 4496'
Show depth and thickness of all water, oil and gas formations.

OIL, GAS OR WATER RECORDS

CASING RECORD

FORMATION	CONTENT	FROM	TO	SIZE	PUT IN	PULLED OUT
				10 3/4"	908'	none
				5 1/2"	4496'	1,594.07'

Describe in detail the manner in which the well was plugged, indicating where the mud fluid
was placed and the method or methods used in introducing it into the hold. If cement or other
plugs were used, state the character of same and depth placed, from feet to
feet for each plug set.

Measured total depth and sanded back to 4300'. Dumped in 5 sacks cement and
welded on 5 1/2" collar.
Shot pipe at 1600'.
Pulled a total of 50 joints of 5 1/2" casing.
Set a rock bridge at 375' to 350'.
Plugged well with 7 yds. ready-mix concrete.

RECEIVED
STATE CORPORATION COMMISSION

APR 28 1977

4-28-77

CONSERVATION DIVISION
Wichita, Kansas

(If additional description is necessary, use BACK of this sheet)

Name of Plugging Contractor Rockhold Engineering, Inc.
P. O. Box 698, Great Bend, Kansas 67530

STATE OF Kansas COUNTY OF Barton ss.

James W. Rockhold (employee of owner) or (owner or operator) of the above-described

well, being first duly sworn on oath, says: That I have knowledge of the facts, statements, and matters herein contained and the log of the
above-described well as filed and that the same are true and correct. So help me God.



(Signature)

James W. Rockhold

Box 698, Great Bend, Kansas 67530

(Address)

Subscribed and sworn to before me this 27th day of April 19 77

Marla K. Haslam

My commission expires May 21, 1980

Marla K. Haslam

Notary Public

CONTINENTAL OIL COMPANY - Operator

SIFRA PETROLEUM CO., INC. - Contr.

ED BREHM #3
SW NW NW
Sec. 26-28S-13W
Pratt County, Kansas

T. D.: 4496'

Commenced: 5-1-62
Completed: 5-17-62

Casing:	Cement:
8-5/8" Set at 914'	with 350 sx. cement
5-1/2" Set at 4492'	with 350 sx. cement

FORMATION	DEPTH
Clay and Sand	70
Sand	215
Red Bed	340
Red Bed, Shale & Gyp	670
Red Bed & Shale	920
Shale, Shells & Salt	1470
Shale & Shells	1878
Shale & Lime	3361
Lime	3429
Shale & Lime	3537
Lime	4290
Chert & Sand	4315
Simpson	4391
Lime	4496

RECEIVED
STATE CORPORATION COMMISSION

MAR 18 1977

CONSERVATION DIVISION
Wichita, Kansas

STATE OF KANSAS)
) ss:
COUNTY OF RUSSELL)

I hereby certify that the above information is true and correct to the best of my knowledge.

C.T. Henaker

Subscribed and sworn to before me this 21st day of May, 1962.

LeRoy Sutz
Notary Public

My commission expires: 10-17-63

State Corp. Comm
Kansas Geological Society
CRW
File

