

STATE OF KANSAS
STATE CORPORATION COMMISSION

WELL PLUGGING RECORD

Give All Information Completely
Make Required Affidavit
Mail or Deliver Report to:
Conservation Division
State Corporation Commission
800 Bitting Building
Wichita, Kansas

Haskell County, Sec. 32 Twp. 29 Rge. 32W (E) (W)

Location as "NE/CNW/SW" or footage from lines. 2000' E. Line, 1250' N. line

Lease Owner Northern Natural Gas Co.

Lease Name City of Sublette Well No. 1

Office Address 2223 Dodge Street, Omaha, Nebraska

Character of Well (completed as Oil, Gas or Dry Hole) Gas

Date well completed 10-10 19 55

Application for plugging filed 5-6 19 64

Application for plugging approved 5-8 19 64


Plugging commenced 5-11 19 64

Plugging completed 5-11 19 64

Reason for abandonment of well or producing formation Well Making too much water.

If a producing well is abandoned, date of last production April 19 63

Was permission obtained from the Conservation Division or its agents before plugging was commenced? Yes

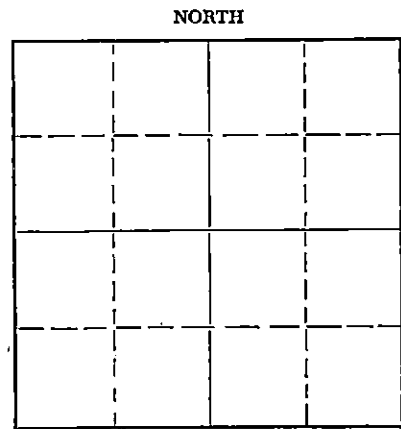

Locate well correctly on above Section Plat

Name of Conservation Agent who supervised plugging of this well Hugh Scott

Producing formation Herrington, Kridler Depth to top 2615 Bottom 2720 Total Depth of Well 2668 Feet

Show depth and thickness of all water, oil and gas formations.

OIL, GAS OR WATER RECORDS

CASING RECORD

FORMATION	CONTENT	FROM	TO	SIZE	PUT IN	PULLED OUT
				8 5/8	522	None
				5 1/2	2667	None Circulated

Describe in detail the manner in which the well was plugged, indicating where the mud fluid was placed and the method or methods used in introducing it into the hole. If cement or other plugs were used, state the character of same and depth placed, from _____ feet to _____ feet for each plug set.

Mix 10 sacks of cement to plug off open perforations at 2625 stopping plug at 2525'. Mud to 450' and pump 10 sacks of cement at 450' to 350'. Mud to 60' and pump 6 sacks of cement at 60' to 0. Have welder cut casing off 3' below ground level and weld cap on same.

RECEIVED
STATE CORPORATION COMMISSION

5-27-64 MAY 27 1964

CONSERVATION DIVISION
Wichita, Kansas

(If additional description is necessary, use BACK of this sheet)
Name of Plugging Contractor Sargents Casing Pulling Service
Address Box 506 Liberal, Kansas

STATE OF Kansas, COUNTY OF Stevens, ss.
Richard G. Schmidt (employee of owner) or (owner or operator) of the above-described well, being first duly sworn on oath, says: That I have knowledge of the facts, statements, and matters herein contained and the log of the above-described well as filed and that the same are true and correct. So help me God.

(Signature) Richard G. Schmidt
Box 1069 Hugoton, Kansas (Address)

SUBSCRIBED AND SWORN TO before me this 26 day of May, 19 64

My commission expires 6-9-1966 Notary Public.

WELL LOG

City of Sublette #1
 Section 32-29S-32W
 Haskell County, Kansas

0-40' Sand and Clay
 40-100' Sand and Shale
 100-350' Sand
 350-470' Sand, Shale and Shells
 470-500' Sand and Clay
 500-675' Blue Shale
 675-735' Sand and Shale
 735-1140' Red Beds and Shale
 1140-1385' Red Beds
 1385-1600' Red Beds, Shale and Shells
 1600-1685' Salt, Shale and Shells
 1685-1830' Shale and Red Beds
 1830-1935' Anhydrite
 1935-2105' Anhydrite, Shale and Shells
 2105-2215' Anhydrite, Shale and Shells
 2215-2242' Lime
 2242-2730' Lime and Shale
 2730-2768' Lime

RECEIVED
 STATE CORPORATION COMMISSION

MAY 27 1964

CONSERVATION DIVISION
 Wichita, Kansas

Correct
 Richard G. Schmidt