


STATE OF KANSAS  
STATE CORPORATION COMMISSION

WELL PLUGGING RECORD

Give All Information Completely  
Make Required Affidavit  
Mail or Deliver Report to  
Conservation Division  
State Corporation Comm.  
245 North Water  
Wichita, KS 67202

Haskell County, Sec. 36 Twp. 29S Rge. 32W E/W  
Location as "NE/CNW $\frac{1}{2}$ SW $\frac{1}{4}$ " or footage from lines  
1250 SNL 1250' EWL

Lease Owner Wallace Oil & Gas, Inc.  
Lease Name Tripp Well No. 1  
Office Address 50 Penn Place Suite 600 Okla. City, Okla. 73118  
Character of Well (Completed as Oil, Gas or Dry Hole)

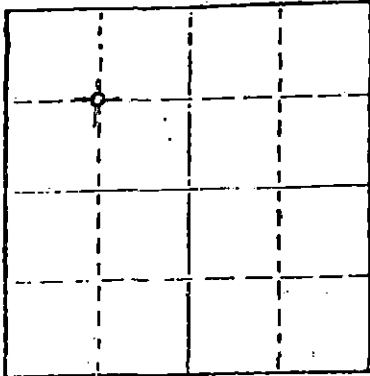

Locate well correctly on above  
Section Plot

Gas  
Date Well completed 19  
Application for plugging filed 12-10 1979  
Application for plugging approved 12-12 1979  
Plugging commenced 12-17 1979  
Plugging completed 12-19 1979  
Reason for abandonment of well or producing formation

If a producing well is abandoned, date of last production 19

Was permission obtained from the Conservation Division or its agents before plugging was commenced? Yes

Name of Conservation Agent who supervised plugging of this well Clarence Thomas  
Producing formation Depth to top Bottom Total Depth of Well 2776  
Show depth and thickness of all water, oil and gas formations.

OIL, GAS OR WATER RECORDS

CASING RECORD

FORMATION	CONTENT	FROM	TO	SIZE	PUT IN	PULLED OUT
				8 5/8	652	none
				4 1/2	2782	1326

Describe in detail the manner in which the well was plugged, indicating where the mud fluid was placed and the method or methods used in introducing it into the hold. If cement or other plugs were used, state the character of same and depth placed, from feet to feet for each plug set,

Pump 15 sks. of cement @ 2737 to 2600  
Pump 35 sks. of cement @ 540 to 645  
Pud. 10 sks. of cement @ 40 to 0

RECEIVED  
STATE CORPORATION COMMISSION

JAN - 8 1980 1-8-80

(If additional description is necessary, use BACK of Conservation Dept.)

Name of Plugging Contractor Sargents Casing Pulling Service Box 506 Liberal, Kansas 67901

STATE OF Oklahoma COUNTY OF Oklahoma, ss.  
Phil Wallace (employee of owner) or (owner or operator)  
of the above-described well, being first duly sworn on oath, says: That I have knowledge of the facts, statements, and matters herein contained and the log of the above-described well as filed and that the same are true and correct. So help me God.

(Signature) Phil Wallace  
50 Penn Place, Suite 600, Okla. City, Okla.  
(Address) 73118

SUBSCRIBED AND SWORN TO before me this 7th day of January, 1980

Betty Jean Wheeler  
Notary Public.

My commission expires 12-2-82