




WELL PLUGGING RECORD

Give All Information Completely
Make Required Affidavit
Mail or Deliver Report to:
Conservation Division
State Corporation Commission
212 North Market, Insurance Bldg.
Wichita, Kansas

HASKELL County. Sec. 13 Twp. 29 Rge. 33W (E) (W)

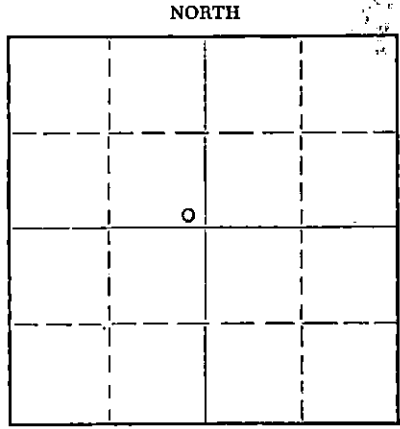

Locate well correctly on above Section Plat

Location as "NE/CNW/SW" or footage from lines NW NW SE
Lease Owner KANSAS NATURAL GAS INC.
Lease Name WRIGHT Well No. 1
Office Address BOX 599 HAYS, KANSAS
Character of Well (completed as Oil, Gas or Dry Hole) GAS
Date well completed SEPTEMBER 12 19 52
Application for plugging filed OCTOBER 26 19 59
Application for plugging approved OCTOBER 26 19 59
Plugging commenced August 12 19 59
Plugging completed DECEMBER 1 19 59
Reason for abandonment of well or producing formation Casing failure and failure of cementing tool on Aug. 12th.
If a producing well is abandoned, date of last production July 19 59
Was permission obtained from the Conservation Division or its agents before plugging was commenced? Yes

Name of Conservation Agent who supervised plugging of this well Mr. Merle A. Rives, 307 Hackberry, Garden City, Ks
Producing formation Hugoton Depth to top 2636 Bottom 2725 Total Depth of Well 2725 Feet
Show depth and thickness of all water, oil and gas formations.

OIL, GAS OR WATER RECORDS

CASING RECORD

FORMATION	CONTENT	FROM	TO	SIZE	PUT IN	PULLED OUT
Herington	Gas	2636	2646	10 3/4"	560	None
Krider	Gas	2660	2688	7"	2715	None
Winfield	Gas	2712	2725	4"	2550	2,062
				Surface and 7" production strings cemented to top.		

Describe in detail the manner in which the well was plugged, indicating where the mud fluid was placed and the method or methods used in introducing it into the hole. If cement or other plugs were used, state the character of same and depth placed, from feet to feet for each plug set.

Cement, 125 sacks pozmix from 2725' to 2525'
Mud, from 2525' to 1,000'
Cement 25 sacks, 1,000' to approx. 950'.
Mud from 950' to 35'
Cement from 35' to base of cellar.
Welded on cap.

RECEIVED
STATE CORPORATION COMMISSION

DEC 7 1959 12-7-59

CONSERVATION DIVISION
Wichita, Kansas

(If additional description is necessary, use BACK of this sheet)
Name of Plugging Contractor Alf Yocum Tubing Service, Hooker, Okla. & Sun Cementing Co.
Address Liberal, Kansas

STATE OF Kansas, COUNTY OF Finney, ss.
Ralph Hinkle (employee of owner) or (owner or operator) of the above-described well, being first duly sworn on oath, says: That I have knowledge of the facts, statements, and matters herein contained and the log of the above-described well as filed and that the same are true and correct. So help me God.

(Signature) Ralph Hinkle
Ralph Hinkle, Supt. Box 455, Garden City, Ks.
(Address)

SUBSCRIBED AND SWORN TO before me this 3rd day of December, 19 59

Tess C. Munn
Notary Public.

My commission expires June 13, 1962




WELL LOG BUREAU—KANSAS GEOLOGICAL SOCIETY
508 East Murdock, Wichita, Kansas

Company: B & R DRILLING, INC.
Farm: Wright No. 1

SEC. 13 T. 29 R. 33W
NW NW NW SE
100' N. & 100' W. of Center

County: Haskell
KANSAS

Total Depth. 2725
Comm. 8-18-52 Comp. 8-25-52
Shot or Treated.
Contractor.
Issued. 11-15-52

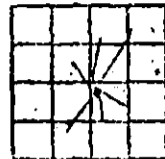

Elevation. 2926

Production. 41,388,000 Gas

CASING:

10 3/4" 560' cem. w/400 sx
7" 2715'

Figures Indicate Bottom of Formations.

surface soil, clay	40
clay	60
sand; gravel	355
clay, gravel	400
sand	540
shale	590
sand	690
red bed, shells	770
red bed	1255
anhydrite	1285
red bed	1625
red bed, shale, shells	1778
anhydrite	1795
salt	1845
salt, shale	1945
shale, shells	2315
anhy. shale; red bed	2410
lime, shale, anhy.	2480
shale, lime	2535
anhy. shale	2680
shale	2718
lime	2720
lime	2725
Total Depth	

Scout Tops:	
Herington	2636
Krider	2652
Winfield	2712