


STATE OF KANSAS
STATE CORPORATION COMMISSION

WELL PLUGGING RECORD

Give All Information Completely
Make Required Affidavit
Mail or Deliver Report to:
Conservation Division
State Corporation Commission
800 Bittling Building
Wichita, Kansas

Haskell County, Sec. 8 Twp. 29S Rge. 34 (E) W (W)

Location as "NE/CNW/SW" or footage from lines _____
Lease Owner United Producing Company, Inc.
Lease Name A.J. Collingwood Well No. 4
Office Address Drawer 30, Liberal, Kansas
Character of Well (completed as Oil, Gas or Dry Hole) Dry Hole
Date well completed October 31, 19 58
Application for plugging filed November 6, 19 58
Application for plugging approved November 5, (Mr. M.A. Rives) 19 58
Plugging commenced November 6, 19 58
Plugging completed November 6, 19 58
Reason for abandonment of well or producing formation Dry Hole

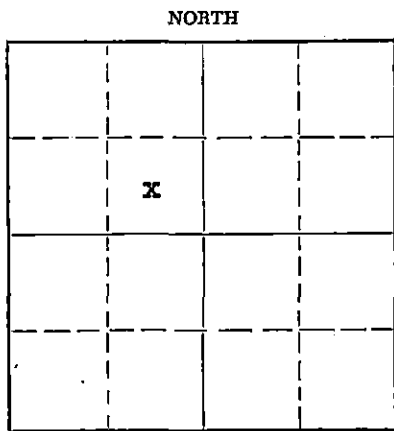

Locate well correctly on above Section Plat

If a producing well is abandoned, date of last production _____ 19 _____
Was permission obtained from the Conservation Division of its agents before plugging was commenced? Yes

Name of Conservation Agent who supervised plugging of this well M.A. Rives
Producing formation Dry Hole Depth to top _____ Bottom _____ Total Depth of Well 5 908 Feet
Show depth and thickness of all water, oil and gas formations.

OIL, GAS OR WATER RECORDS

CASING RECORD

| FORMATION | CONTENT | FROM | TO | SIZE | PUT IN | PULLED OUT |
|-----------|---------|------|----|-------|--------|------------|
| | | | | 8 5/8 | 1 804 | None |
| | | | | | | |
| | | | | | | |
| | | | | | | |
| | | | | | | |
| | | | | | | |
| | | | | | | |
| | | | | | | |
| | | | | | | |

Describe in detail the manner in which the well was plugged, indicating where the mud fluid was placed and the method or methods used in introducing it into the hole. If cement or other plugs were used, state the character of same and depth placed, from _____ feet to _____ feet for each plug set.

Ran tubing to 5700', pumped cement through tubing 5700' to 5600' heavy mud to 2950', spotted cement from 2950' to 2650'. Heavy mud to 600', cement to 550'. Heavy mud to 35', cement to base.

RECEIVED
STATE CORPORATION COMMISSION

NOV 12 1958

CONSERVATION DIVISION
Wichita, Kansas

11-12-58

(If additional description is necessary, use BACK of this sheet)

Name of Plugging Contractor United Producing Company, Inc.
Address Drawer 30, Liberal, Kansas (Halliburton)

STATE OF KANSAS, COUNTY OF SEWARD, ss.
L.S. BROWN (employee of owner) or (owner or operator) of the above-described well, being first duly sworn on oath, says: That I have knowledge of the facts, statements, and matters herein contained and the log of the above-described well as filed and that the same are true and correct. So help me God.

(Signature) L.S. Brown
Drawer 30, Liberal, Kansas
(Address)

SUBSCRIBED AND SWORN to before me this 7th day of November, 1958

L.S. Brown
Notary Public.

My commission expires 1-30-60

PLUGGING
FILE SEC 8 T. 29 R. 34W
BOOK PAGE 143 LINE 24

LOG OF W.E.L.L.

Drilled by: Ward A. McGinnis
For: Glenwood Oil Company

WIGGINS W - 8
LOCATION:

ROTARY COMMENCED: October 6, 1956
ROTARY COMPLETED: October 11, 1956
TOTAL DEPTH: 1849 GM

| FORMATION | FROM | TO |
|-----------------------------|------|------|
| Shale | 0 | 10 |
| Lime | 10 | 25 |
| Shale | 25 | 31 |
| Lime | 31 | 37 |
| Shale | 37 | 45 |
| Shale | 45 | 65 |
| Lime | 65 | 74 |
| Shale | 74 | 95 |
| Shale | 95 | 96 |
| Lime and shale | 96 | 131 |
| Lime and Shale | 131 | 411 |
| Lime and Shale | 411 | 631 |
| Lime and shale | 631 | 852 |
| Sand | 852 | 959 |
| Lime | 959 | 1004 |
| Lime | 1004 | 1109 |
| Shale | 1109 | 1128 |
| Shale | 1128 | 1231 |
| Shale | 1231 | 1239 |
| Lime | 1239 | 1324 |
| Lime | 1324 | 1386 |
| Lime | 1386 | 1424 |
| Shale and shells | 1424 | 1486 |
| Shale and shells | 1486 | 1576 |
| Shale and shells | 1576 | 1661 |
| Shale and shells | 1661 | 1744 |
| Shale and shells | 1744 | 1797 |
| Shale | 1797 | 1807 |
| Core #1 Cut 28' Rec. 27.80' | 1807 | 1835 |
| Shale | 1835 | 1849 |

Ran 88' x 7" pipe

Ran 1863' x 4 1/2" pipe
cemented w/150 sax cement

STATE

PLUGGING
FILE SEC 8 T 29 R 340
BOOK PAGE 143 LINE 24