


STATE OF KANSAS
STATE CORPORATION COMMISSION

WELL PLUGGING RECORD

Give All Information Completely
Make Required Affidavit
Mail or Deliver Report to:
Conservation Division
State Corporation Commission
211 No. Broadway
Wichita, Kansas

Haskell County. Sec. 21 Twp. 29S Rge. (E) 34 (W)
Location as "NE/CNW&SW" or footage from lines NW-SW
Lease Owner Ashland Oil, Inc.
Lease Name O.V. Ray Well No. 5-21
Office Address 50 Penn Place, Suite 1200, Okla. City, Okla. 73118
Character of Well (completed as Oil, Gas or Dry Hole) Dry Hole
Date well completed _____ 19____
Application for plugging filed _____ 19____
Application for plugging approved _____ 19____
Plugging commenced _____ 1-23 _____ 19 75
Plugging completed _____ 1-23 _____ 19 75
Reason for abandonment of well or producing formation Dry Hole

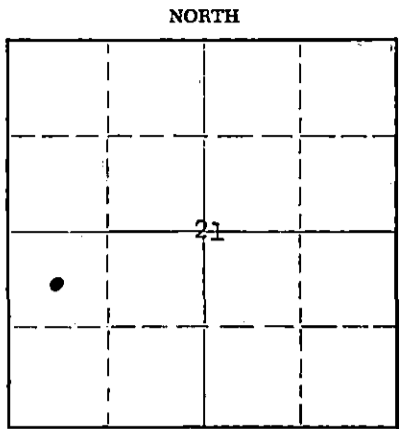

Locate well correctly on above
Section Plat

If a producing well is abandoned, date of last production _____ 19____
Was permission obtained from the Conservation Division or its agents before plugging was commenced? Yes

Name of Conservation Agent who supervised plugging of this well Clarence Thomas
Producing formation None Depth to top _____ Bottom _____ Total Depth of Well 5500 Feet
Show depth and thickness of all water, oil and gas formations.

OIL, GAS OR WATER RECORDS

CASING RECORD

| FORMATION | CONTENT | FROM | TO | SIZE | PUT IN | PULLED OUT |
|---------------------|---------|------|------|-------|--------|------------|
| Fresh Water | | Surf | 500' | 8-5/8 | 1351 | None |
| No Productive Zones | | | | | | |
| | | | | | | |
| | | | | | | |

Describe in detail the manner in which the well was plugged, indicating where the mud fluid was placed and the method or methods used in introducing it into the hole. If cement or other plugs were used, state the character of same and depth placed, from 1400, 500 feet to 1250, 400 feet for each plug set.

Set 60 sx plug 1400 to 1250'. Set 40 sx plug 500 to 400'. Set 20 sx plug 30' to surface.

RECEIVED
STATE CORPORATION COMMISSION

FEB 7 1975 2-7-75

CONSERVATION DIVISION
Wichita, Kansas

(If additional description is necessary, use BACK of this sheet)
Name of Plugging Contractor Zenith Drilling Company
Address _____

STATE OF Oklahoma COUNTY OF Oklahoma, ss.
Carl K Johnson (employee of owner) or (owner or operator) of the above-described well, being first duly sworn on oath, says: That I have knowledge of the facts, statements, and matters herein contained and the log of the above-described well as filed and that the same are true and correct. So help me God.

(Signature) Carl K Johnson
50 Penn Place, Suite 1200, Okla. City, Okla
(Address) 73118

SUBSCRIBED AND SWORN to before me this 28th day of January, 1975

My commission expires 12-22-75

Lawana Butler
Notary Public.



WELL LOG

COMPANY Ashland Oil Company

SEC. 21-29S-34W

FARM O.V. Ray

NO. 5-21

LOC. C NW SW

TOTAL DEPTH 5500'


COUNTY Haskell

COMM. 1-9-75

COMP. 1-23-75

CONTRACTOR Zenith Drilling Corporation, Inc.

CASING Ran 1350' of 8 5/8" casing w/685 sxs cement

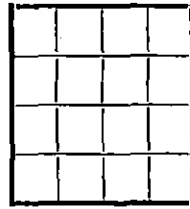

ELEVATION

PRODUCTION

FIGURES INDICATE BOTTOM OF FORMATIONS

| | | |
|------|------|-----------------|
| 0 | 358 | Sand & Clay |
| 358 | 1351 | Redbed & Sand |
| 1351 | 2595 | Redbed & Shale |
| 2595 | 3270 | Lime & Shale |
| 3270 | 5082 | Lime |
| 5082 | 5280 | Lime & Shale |
| 5280 | 5380 | Lime |
| 5380 | 5500 | Lime & Shale |
| 5500 | TD | Dry & Abandoned |

1st plug 60 sxs cement @ 1400'
 2nd plug 40 sxs cement @ 540'
 3rd plug 20 sxs cement 50' to surface
 11:00P.M. 1-23-75

RECEIVED
 STATE CORPORATION COMMISSION
 FEB 19 1975
 CONSERVATION DIVISION
 Wichita, Kansas

State of Kansas }
 County of Sedgwick } ss

I, C. Robert Buford of Zenith Drilling Corporation, Inc.

upon oath state the above and foregoing is a true and correct copy of the log of the O.V. Ray # 5-21 well.

C. Robert Buford

Subscribed and sworn to before me this 30th day of January, 19 75.

My Commission Expires: August 15, 1975

Myrna D. Murphy
 Myrna D. Murphy NOTARY PUBLIC