

Give All Information Completely
Make Required Affidavit
Mail or Deliver Report to:
Conservation Division
State Corporation Commission
211 No. Broadway
Wichita, Kansas

WELL PLUGGING RECORD

Kingman County, Sec. 22 Twp. 30S Rge. 7 ~~W~~ W (W)

Location as "NE/CNW/SW" or footage from lines Approx. 60' West of C SE SW NW

Lease Owner Clinton Oil Company

Lease Name Vanlandingham Well No. 6-D

Office Address 6810 West Highway U.S. 54, Wichita, Kansas 67209

Character of Well (completed as Oil, Gas or Dry Hole) Dry Hole

Date well completed November 14 1965

Application for plugging filed November 14 1965


Application for plugging approved November 14 1965

Plugging commenced November 14 1965

Plugging completed November 14 1965

Reason for abandonment of well or producing formation D & A

NORTH

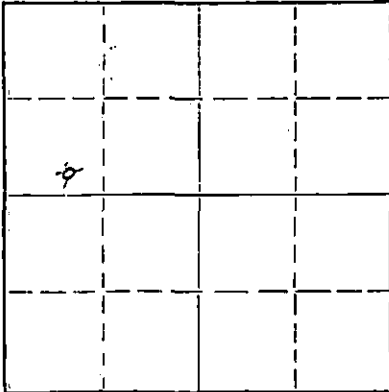

Locate well correctly on above
Section Plat

If a producing well is abandoned, date of last production 19

Was permission obtained from the Conservation Division or its agents before plugging was commenced? Yes

Name of Conservation Agent who supervised plugging of this well A. Elving

Producing formation Depth to top Bottom Total Depth of Well 4260 Feet

Show depth and thickness of all water, oil and gas formations.

OIL, GAS OR WATER RECORDS

CASING RECORD

FORMATION	CONTENT	FROM	TO	SIZE	PUT IN	PULLED OUT
				8 5/8"	262	none

Describe in detail the manner in which the well was plugged, indicating where the mud fluid was placed and the method or methods used in introducing it into the hole. If cement or other plugs were used, state the character of same and depth placed, from feet to feet for each plug set.

Plugged with heavy mud to 250'. Bridged with 2 sx Dry Cement, 1/2 sack hulls. Set plug with 23 sx cement. Mud to 40', 1 sx dry cement and 1/3 sack hulls. Set plug with 9 sx cement to base of cellar. 2 sx cement in rat hole. Job complete at 8:00 P.M. November 14, 1965.

RECEIVED
STATE CORPORATION COMMISSION

NOV 18 1965 11-18-65

CONSERVATION DIVISION

(If additional description is necessary, use BACK of this sheet)

Name of Plugging Contractor Garvey Drilling Co.

Address Rt. 2, Great Bend, Kansas

STATE OF KANSAS, COUNTY OF SEDGWICK, ss.

H. Marvin Douglas (employee of owner) or (owner or operator) of the above-described well, being first duly sworn on oath, says: That I have knowledge of the facts, statements, and matters herein contained and the log of the above-described well as filed and that the same are true and correct. So help me God.

(Signature) H. Marvin Douglas
H. Marvin Douglas
6810 West Highway U.S. 54, Wichita, Kansas
(Address)

SUBSCRIBED AND SWORN TO before me this 17th day of November, 1965

Allen T. Denton
Allen T. Denton Notary Public.

My commission expires January 24, 1968

WELL LOG

COMPANY **Clinton Oil Company**

SEC. 22 T. 30S R. 7W

FARM **Vanlandingham** NO. **6-D**

LOC. **C SE SW NW**


TOTAL DEPTH **4257'**

COUNTY **Kingman**

COMM. **11-4-65**

COMP. **11-14-65**

CONTRACTOR **Garvey Drilling Company**

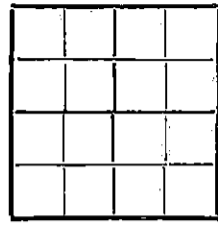

CASING **8 5/8" @ 262' w/200 sx**

ELEVATION

PRODUCTION **D & A**

FIGURES INDICATE BOTTOM OF FORMATIONS

- 262' Shale and Red Bed
- 1080' Red Bed and Shale
- 1095' Lime
- 2910' Lime and Shale
- 3105' Sandy Lime with Shale
- 3255' Shale and Lime
- 3465' Sandy Lime with Shale
- 3545' Lime with Shale
- 3720' Shale and Lime
- 3909' Lime
- 4002' Lime with Shale
- 4095' Lime
- 4190' Lime and Shale
- 4216' Mississippi Chert
- 4257' Mississippi
- 4257' RTD

RECEIVED
STATE COMMISSION

DEC -2 1965

MINING DIVISION
Kansas

State of Kansas }
County of Barton } SS

I, Sam N. Stephens of Garvey Drilling Company

upon oath state the above and foregoing is a true and correct copy of the log of the Vanlandingham #6-D well.

Sam N. Stephens

Subscribed and sworn to before me this 17th day of November 19 65

My Commission Expires: November 5, 1969

Richard Hoops
NOTARY PUBLIC