


STATE OF KANSAS
STATE CORPORATION COMMISSION

Form CP-4

WELL PLUGGING RECORD

Give All Information Completely
Make Required Affidavit
Mail or Deliver Report to:
Conservation Division
State Corporation Commission
P. O. Box 17027
Wichita, Kansas 67217
NORTH

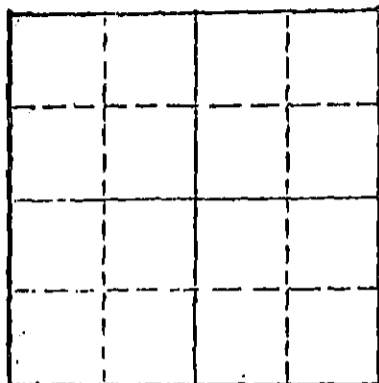

Locate well correctly on above
Section Flat

Kingman County, Sec. 22 Twp. 30 Rge. 7 (E) (W)
Location as "NE/CNW/SE/SW" or footage from lines NW NE
Lease Owner Chinton Oil Company
Lease Name Cronley Estate #1 2 Well No.
Office Address Wichita, Kansas 67202
Character of Well (completed as Oil, Gas or Dry Hole) Oil Well 9x23x
Date well completed 9-23-65 19
Application for plugging filed 10-9-73 19
Application for plugging approved 10-11-73 19
Plugging commenced 1/8/74 19
Plugging completed 1/17/74 19
Reason for abandonment of well or producing formation depleted.

If a producing well is abandoned, date of last production 19
Was permission obtained from the Conservation Division or its agents before plugging was commenced? yes

Name of Conservation Agent who supervised plugging of this well Biberstein
Producing formation Depth to top Bottom Total Depth of Well 4285 Feet
Show depth and thickness of all water, oil and gas formations.

OIL, GAS OR WATER RECORDS

CASING RECORD

FORMATION	CONTENT	FROM	TO	SIZE	PUT IN	PULLED OUT
Mississippi				8-5/8	258	none
				5 1/2"	4283	3717'

Describe in detail the manner in which the well was plugged, indicating where the mud fluid was placed and the method or methods used in introducing it into the hole. If cement or other plugs were used, state the character of same and depth placed, from feet to feet for each plug set.

Checked hole to 4285', ran sand to 4200' and set 5 sacks cement.
Shot pipe at 3816', 3706', pulled 113 joints. Set 10' rock bridge
at 200' and ran 5 sacks cement on top to keep fluid down. Ran 5 yards
ready mix.

PLUGGING COMPLETE.

RECEIVED
STATE CORPORATION COMMISSION
JAN 30 1974
CONSERVATION DIVISION
Wichita, Kansas

1-30-74

(If additional description is necessary, use BACK of this sheet)
Name of Plugging Contractor KNIGHT CASING PULLING CO., INC.
Address CHASE, KANSAS

STATE OF KANSAS COUNTY OF RICE ss.
NOEL J. KNIGHT (employee of owner) or (owner or operator) of the above-described
well, being first duly sworn on oath, says: That I have knowledge of the facts, statements, and matters herein contained and the log of the
above-described well as filed and that the same are true and correct. So help me God.

(Signature) Noel Knight
CHASE, KANSAS (Address)

Subscribed and Sworn to before me this 18th day of January 1974

My commission expires
MARGARET MELCHER
NOTARY PUBLIC
Rice County, Kansas
My Commission Expires
Feb. 15, 1975

Margaret Melcher
Notary Public.

WELL LOG ¹⁵⁻⁰⁹⁵⁻³⁰²⁶³⁻⁰⁰⁰⁰

COMPANY Clinton Oil Company

SEC. 22 T. 30S R. 7W

FARM Crumley

NO. 2-X

LOC. 660' S & 330' E of
NW corner of NE/4


TOTAL DEPTH 4284'

COUNTY Kingman

COMM. 9-12-65

COMP. 9-23-65

CONTRACTOR Garvey Drilling Company

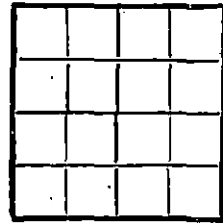

CASING 8 5/8" @ 258.74' w/200 sx

5 1/2" @ 4283' w/100 sx

ELEVATION 1516' DF

PRODUCTION

FIGURES INDICATE BOTTOM OF FORMATIONS

35' Post Rock and Red Bed
 425' Shale, Shells and Red Bed
 1125' Shale and Shells
 1700' Shale and Lime
 2445' Lime and Shale
 2845' Shale and Lime
 3559' Lime and Shale
 4155' Lime
 4209' Lime and Shale
 4215' Chert
 4222' Lime
 4228' Cherty Lime
 4284' Chert
 4284' RTD

RECEIVED
 STATE CORPORATION COMMISSION
 OCT 11 1973
 CONSERVATION DIVISION
 Wichita, Kansas

State of Kansas
 County of Barton

I, Sam N. Stephens of Garvey Drilling Company

upon oath state the above and foregoing is a true and correct copy of the log of the Crumley 2-X well.

Sam N. Stephens

Subscribed and sworn to before me this 30th day of September 19 65

My Commission Expires: May 28, 1969

Richard H. Dinkler
NOTARY PUBLIC