

STATE OF KANSAS  
STATE CORPORATION COMMISSION


Form CP-4

WELL PLUGGING RECORD

Give All Information Completely  
Make Required Affidavit  
Mail or Deliver Report to:  
Conservation Division  
State Corporation Commission  
P. O. Box 17027  
Wichita, Kansas 67217  
NORTH

Kingman County, Sec. 22 Twp. 30 Rge. 7 (W)

Location as "NE/CNW/SW" or footage from lines.  
Lease Owner: Clinton Oil Company  
Lease Name: Vanlandingham D#2 Well No.  
Office Address: Great Bend, Kansas 67530  
Character of Well (completed as Oil, Gas or Dry Hole): oil  
Date well completed: 9-23-65 19  
Application for plugging filed: 6-1-72 19  
Application for plugging approved: 6-2-72 19  
Plugging commenced: 6/20/72 19  
Plugging completed: 6/22/72 19  
Reason for abandonment of well or producing formation: depleted.

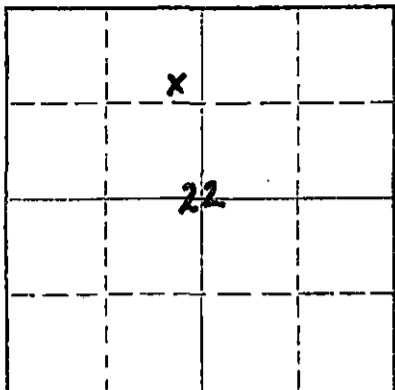

Locate well correctly on above Section Flat

If a producing well is abandoned, date of last production: 8-10-71 19  
Was permission obtained from the Conservation Division or its agents before plugging was commenced? yes

Name of Conservation Agent who supervised plugging of this well: Biberstein  
Producing formation: Miss. Depth to top: 4200 Bottom: 4208 Total Depth of Well: 4275 Feet  
Show depth and thickness of all water, oil and gas formations. (perms)

OIL, GAS OR WATER RECORDS

CASING RECORD

FORMATION	CONTENT	FROM	TO	SIZE	PUT IN	PULLED OUT
Mississippi	oil	4190	4271	8-5/8 5 1/2"	268 4274'	none 3507'

Describe in detail the manner in which the well was plugged, indicating where the mud fluid was placed and the method or methods used in introducing it into the hole. If cement or other plugs were used, state the character of same and depth placed, from feet to feet for each plug set.

Checked hole to 4240', ran sand to 4175' and ran 5 sacks of cement. Loaded hole with water, shot pipe at 2677', 2505', pulled 108 joints. Set rock bridge at 265' and ran 4 1/2 yards concrete. Racked unit and tallied pipe.

PLUGGING COMPLETE.

RECEIVED  
STATE CORPORATION COMMISSION  
JUL 10 1972  
7-10-72  
CONSERVATION DIVISION  
Wichita, Kansas

(If additional description is necessary, use BACK of this sheet)  
Name of Plugging Contractor: KNIGHT CASING PULLING CO., INC.  
Address: CHASE, KANSAS

STATE OF KANSAS, COUNTY OF RICE, ss.  
NOEL J. KNIGHT (employee of owner) or (owner or operator) of the above-described well, being first duly sworn on oath, says: That I have knowledge of the facts, statements, and matters herein contained and the log of the above-described well as filed and that the same are true and correct. So help me God.

(Signature) Noel Knight  
CHASE, KANSAS (Address)

SUBSCRIBED AND SWORN TO before me this 26th day of June, 1972

My commission expires  
MARGARET MELCHER  
NOTARY PUBLIC  
Rice County, Kansas  
My Commission Expires  
Feb. 15, 1975


Margaret Melcher  
Notary Public.

15-095-30264-0000

# WELL LOG.

COMPANY Clinton Oil Company  
 FARM Vanlandingham NO. 2-D  
 TOTAL DEPTH 4275'  
 COMM. 8-31-65 COMP. 9-12-65  
 CONTRACTOR Garvey Drilling Company

SEC. 22 T. 30S R. 7W  
 LOC. SE-NE-NW  
 COUNTY Kingman

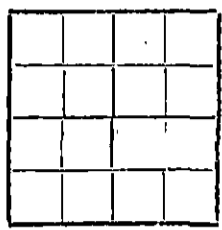

CASING 8 5/8" @ 268' w/200 sx  
5 1/2" @ 4274' w/100 sx

ELEVATION 1504' DF

PRODUCTION

FIGURES INDICATE BOTTOM OF FORMATIONS

- 40' Rock and Shale
- 268' Red Bed and Shale
- 335' Red Bed
- 950' Shale and Shells
- 1235' Shale and Lime
- 1755' Lime and Shale
- 2085' Shale with Lime
- 2565' Lime and Shale
- 2660' Shale and Lime
- 3000' Lime and Shale
- 3225' Shale with Lime
- 3390' Lime and Shale
- 3470' Lansing
- 3585' Lime
- 3710' Lime and Shale
- 3765' Kansas City Lime
- 4089' Lime
- 4180' Shale and Lime
- 4206' Lime
- 4213' Cherty Lime
- 4220' Lime
- 4225' Cherty Lime
- 4275' Lime
- 4275' RTD

RECEIVED  
 STATE CORPORATION COMMISSION  
 JUL 10 1972  
 CONSERVATION DIVISION  
 Wichita, Kansas

State of Kansas  
 County of Barton } 85

I, Sam N. Stephens of Garvey Drilling Company

upon oath state the above and foregoing is a true and correct copy of the log of the Vanlandingham #2-D well.

*Sam N. Stephens*

Subscribed and sworn to before me this 24th day of September 1965

My Commission Expires: May 28, 1969

*Richard N. Dumbler*  
 NOTARY PUBLIC