


STATE OF KANSAS  
STATE CORPORATION COMMISSION

Give All Information Completely  
Make Required Affidavit  
Mail or Deliver Report to:  
Conservation Division  
State Corporation Commission  
P. O. Box 17027  
Wichita, Kansas 67217  
NORTH

WELL PLUGGING RECORD

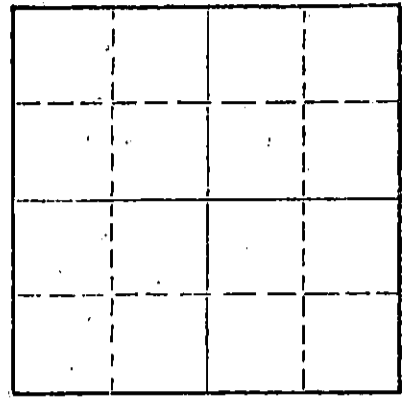

Locate well correctly on above  
Section Plat

Kingman County, Sec. 21 Twp. 30S Rge. (E) 7 (W)  
Location as "NE/CNW/SW" or footage from lines: C NE SW  
Lease Owner Cherokee Resources, Inc.  
Lease Name Vanlandingham Well No. 1  
Office Address 432 Mayo Building, Tulsa, Oklahoma 74103  
Character of Well (completed as Oil, Gas or Dry Hole) Dry Hole  
Date well completed February 14, 19 73  
Application for plugging filed February 14, 19 73  
Application for plugging approved February 14, 19 73  
Plugging commenced February 14, 19 73  
Plugging completed February 14, 19 73  
Reason for abandonment of well or producing formation

If a producing well is abandoned, date of last production 19  
Was permission obtained from the Conservation Division or its agents before plugging was commenced? Yes

Name of Conservation Agent who supervised plugging of this well G. R. Biberstein  
Producing formation Depth to top Bottom Total Depth of Well 4272 Feet  
Show depth and thickness of all water, oil and gas formations.

OIL, GAS OR WATER RECORDS

CASING RECORD

FORMATION	CONTENT	FROM	TO	SIZE	PUT IN	PULLED OUT
				8-5/8"	271'	None

Describe in detail the manner in which the well was plugged, indicating where the mud fluid was placed and the method or methods used in introducing it into the hole. If cement or other plugs were used, state the character of same and depth placed, from feet to feet for each plug set.

Mudded up with heavy mud to 260 feet. Followed by wooden plug and 1/2 sack hulls. Placed 25 sacks cement onto hulls. Mudded up with heavy mud to 40 feet followed by wooden plug, 1/2 sack hulls and 10 sacks cement to base of well cellar. Plugged rat hole with 2 sacks cement.

RECEIVED  
STATE CORPORATION COMMISSION  
FEB 20 1973  
CONSERVATION DIVISION  
Wichita, Kansas  
2-20-73

(If additional description is necessary, use BACK of this sheet)  
Name of Plugging Contractor Graves Drilling Co., Inc.  
Address 505 Union Center, Wichita, Kansas 67202

STATE OF KANSAS, COUNTY OF SEDGWICK, ss.  
John C. Graves (employee of owner) or (owner or operator) of the above-described

well, being first duly sworn on oath, says: That I have knowledge of the facts, statements, and matters herein contained and the log of the above-described well as filed and that the same are true and correct. So help me God.

(Signature) John C. Graves  
505 Union Center, Wichita, Kansas 67202  
(Address)

Subscribed and Sworn to before me this 16th day of February, 1973

Betty Brandt  
Notary Public.

ROTARY DRILLERS' LOG

OPERATOR: Cherokee Resources, Inc. DRILLING COMMENCED: February 7, 1973  
 432 Mayo Building  
 Tulsa, Oklahoma 74103

CONTRACTOR: Graves Drilling Co., Inc. DRILLING COMPLETED: February 14, 1973  
 505 Union Center  
 Wichita, Kansas 67202

CASING RECORD: 13 Jts. 271' 8-5/8" LOCATION: Vanlandingham No. 1  
 cemented with 240 sacks C NE SW  
 Section 21-30S-7W  
 Kingman County, Kansas

0 - 20	Sod and sand
20 - 273	Red bed
273 - 553	Shale
553 - 1400	Shale & shells
1400 - 1505	Shale & lime
1505 - 1800	Lime & shale
1800 - 2035	Lime with shale streaks
2035 - 2970	Shale & lime
2970 - 3200	Lime & sandy shale
3200 - 3495	Shale & lime
3495 - 4235	Lime
4235 - 4261	Shale & lime
4261 - 4272	Chert
4272	Rotary Total Depth

RECEIVED  
 STATE CORPORATION COMMISSION  
 FEB 20 1973  
 CONSERVATION DIVISION  
 Wichita, Kansas

I hereby certify the foregoing statements to be true and correct to the best of my knowledge.

GRAVES DRILLING CO., INC.

By John Graves  
President

STATE OF KANSAS )  
                          ) ss.  
SEDGWICK COUNTY )

Subscribed and sworn to before me, a Notary Public, this 16th of February, 1973.

Betty Brandt  
Betty Brandt Notary Public

My commission expires:  
May 9, 1975