


STATE OF KANSAS  
STATE CORPORATION COMMISSION

WELL PLUGGING RECORD

Give All Information Completely  
Make Required Affidavit  
Mail or Deliver Report to  
Conservation Division  
State Corporation Comm.  
245 North Water  
Wichita, KS 67202

Morton County. Sec. 12 Twp. 32 Rge. 42 NE/W  
Location as "NE/CNW $\frac{1}{4}$ SW $\frac{1}{4}$ " or footage from lines C-NE-SE

Lease Owner Bonanza Petroleum, Inc. (Sovereign Expl.)  
Lease Name HARRISON "A" Well No. 1  
Office Address Box 1578, Liberal, KS 67901  
Character of Well (Completed as Oil, Gas or Dry Hole) DRY HOLE

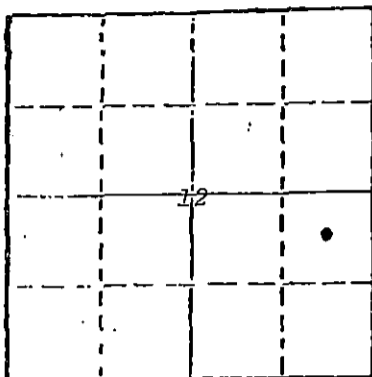

Date Well completed 3/5 19 80  
Application for plugging filed 3/5 19 80  
Application for plugging approved 3/5 19 80  
Plugging commenced 3/5 19 80  
Plugging completed 3/5 19 80  
Reason for abandonment of well or producing formation DRY HOLE

If a producing well is abandoned, date of last production 19

Was permission obtained from the Conservation Division or its agents before plugging was commenced? Yes

Name of Conservation Agent who supervised plugging of this well Clarence Thomas, Jr.  
Producing formation - Depth to top - Bottom - Total Depth of Well 5340'  
Show depth and thickness of all water, oil and gas formations.

OIL, GAS OR WATER RECORDS

CASING RECORD

FORMATION	CONTENT	FROM	TO	SIZE	PUT IN	PULLED OUT
				8-5/8"	1486'	NONE

Describe in detail the manner in which the well was plugged, indicating where the mud fluid was placed and the method or methods used in introducing it into the hold. If cement or other plugs were used, state the character of same and depth placed, from          feet to          feet for each plug set.

plugged well as follows: Set cement plug at 3200' with 25 sks. cement  
Set cement plug at 2850' with 25 sks. cement  
Set cement plug at 1480' with 50 sks. cement  
Set cement plug at 700' with 25 sks. cement  
Set cement plug at 40-0' with 10 sks. cement  
Plugged rathole with 5 sks. cement.  
Cut off pipe and welded on ID cap

(If additional description is necessary, use BACK of this sheet)

Name of Plugging Contractor Halliburton  
Liberal, KS 67901


STATE OF Kansas COUNTY OF Seward, ss.  
C. E. Smith Agent (employee of owner) or (owner or operator)  
of the above-described well, being first duly sworn on oath, says: That I have knowledge of the facts, statements, and matters herein contained and the log of the above-described well as filed and that the same are true and correct. So help me God.

(Signature) C. E. Smith

P.O. Box 1578, Liberal, KS 67901  
(Address)

SUBSCRIBED AND SWORN to before me this 6th day of March, 19 80

My commission expires

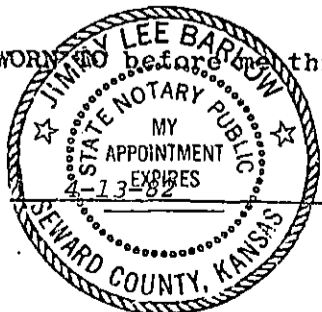

Jimmy Lee Barlow  
Notary Public.

RECEIVED  
STATE CORPORATION COMMISSION

MAR - 7 1980 3-7-80  
CONSERVATION DIVISION  
Wichita, Kansas