


STATE OF KANSAS
STATE CORPORATION COMMISSION
Give All Information Completely
Make Required Affidavit
Mail or Deliver Report to:
Conservation Division
State Corporation Commission
211 No. Broadway
Wichita, Kansas

WELL PLUGGING RECORD

Morton County, Sec. 12 Twp. 32S Rge. (E) 42 (W)

Location as "NE/CNW/SW" or footage from lines. CNW 1/2
Lease Owner Champlin Petroleum Company
Lease Name Harrison Well No. 1-12
Office Address P. O. Box 308, Ellinwood, Kansas 67526
Character of Well (completed as Oil, Gas or Dry Hole) Dry Hole
Date well completed January 28 19 67
Application for plugging filed January 28 19 67
Application for plugging approved January 28 (verbal) 19 67
Plugging commenced January 28 19 67
Plugging completed January 28 19 67
Reason for abandonment of well or producing formation

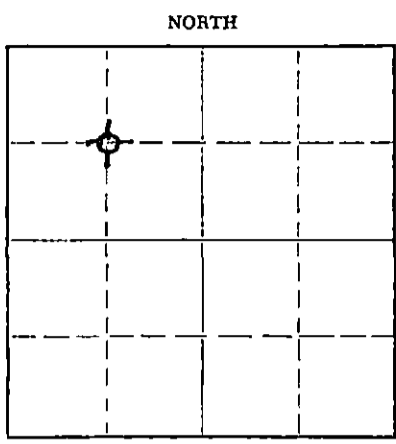

Locate well correctly on above Section Plat

If a producing well is abandoned, date of last production 19
Was permission obtained from the Conservation Division or its agents before plugging was commenced? Yes

Name of Conservation Agent who supervised plugging of this well Mr. E. Eves
Producing formation Depth to top Bottom Total Depth of Well 5210 Feet
Show depth and thickness of all water, oil and gas formations.

OIL, GAS OR WATER RECORDS

CASING RECORD

FORMATION	CONTENT	FROM	TO	SIZE	PUT IN	PULLED OUT
				8 5/8" OD	1474'	None
				2 7/8" OD	5075'	1999'

Describe in detail the manner in which the well was plugged, indicating where the mud fluid was placed and the method or methods used in introducing it into the hole. If cement or other plugs were used, state the character of same and depth placed, from feet to feet for each plug set.
Filled hole with heavy mud from 5210' T.D. to 1990' and pumped in 25 sacks cement then filled hole with heavy mud to 700' and pumped in 35 sacks of cement then filled hole with heavy mud to 45'. Used 1 sack of hulls and 15 sacks of cement to fill hole to bottom of cellar.

RECEIVED
STATE CORPORATION COMMISSION
FEB 9 1967
2-9-67
CONSERVATION DIVISION
Wichita, Kansas

(If additional description is necessary, use BACK of this sheet)
Name of Plugging Contractor Dowell, Inc.
Address Great Bend, Kansas

STATE OF Kansas, COUNTY OF Barton, ss.
J. W. Meyers (employee of owner) or (owner/operator) of the above-described well, being first duly sworn on oath, says: That I have knowledge of the facts, statements, and matters herein contained and the log of the above-described well as filed and that the same are true and correct. So help me God.

(Signature) J. W. Meyers, Opt's. Mgr.
P. O. Box 308, Ellinwood, Kansas 67526
(Address)

SUBSCRIBED AND SWORN TO before me this 3rd day of February, 19 67

My commission expires 5-22-70 Notary Public.

Operator: Champlin Petroleum Company
P. O. Box 308
Ellinwood, Kansas 67526

Location: Harrison #1-12 Cen NW $\frac{1}{4}$ Sec. 12-32S-42W
Morton County, Kansas

Contractor: Holm Drilling Company
Box 7505, Southside Station
Tulsa, Oklahoma 74105

Spud Date: 12-27-66
Completed: 1-14-67
Total Depth: 5210' K.B. Measure = 5201' Ground Level

Depth	Formation Log
0' to 225'	Surface Sand and Clay
225' to 570'	Red Bed and Shale
570' to 695'	Shale and Gyp
695' to 887'	Red Bed
887' to 1040'	Red Bed and Gyp
1040' to 1056'	Gyp and Sand
1056' to 1083'	Gyp
1083' to 1250'	Sand
1250' to 1430'	Shale and Shells
1430' to 1475'	Shale and Shells W/Gyp Streaks
1475' to 1800'	Anhydrite and Shale and Shells
1800' to 2285'	Shale and Shells
2285' to 2450'	Shale W/Lime
2450' to 3272'	Lime and Shale
3272' to 3556'	Lime
3556' to 3820'	Lime and Shale
3820' to 3825'	Lime
3825' to 3985'	Lime and Shale
3985' to 4238'	Lime
4238' to 4295'	Lime and Shale
4295' to 4525'	Lime W/Shale
4525' to 4595'	Lime and Shale
4595' to 4980'	Lime and Shale
4980' to 5000'	Lime, Shale and Sand
5000' to 5057'	Lime, Sand and Shale
5057' to 5066'	Lime and Shale
5066' to 5069'	Sand
5069' to 5107'	Lime and Sand
5107' to 5140'	Lime and Shale
5140' to 5210'	Lime
5210'	T. D.

RECEIVED
STATE CORPORATION COMMISSION
FEB 9 1967
CONSTRUCTION DIVISION
Wichita, Kansas