


15-151-20351-0000

STATE OF KANSAS  
STATE CORPORATION COMMISSION  
CONSERVATION DIVISION  
P. O. BOX 17027  
WICHITA, KANSAS 67217

FORM CP-4

WELL PLUGGING RECORD

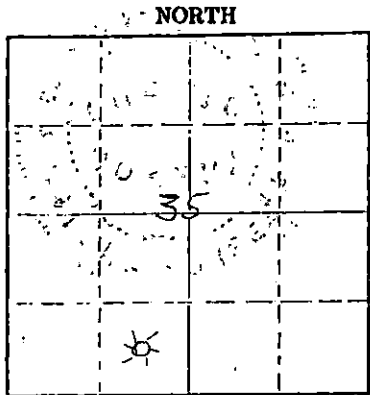

Locate well correctly on above Section Plat

Pratt County, Sec. 35 Twp. 28S Rge. 13 (E) W (W)  
Location as "NE/CNW/SW" or footage from lines C SE SW  
Lease Owner Mahoney Drilling Co., Inc.  
Lease Name Taylor Well No. 1  
Office Address Box 1257, Liberal, Kansas 67901  
Character of Well (completed as Oil, Gas or Dry Hole) Dry Hole  
Date well completed 10/9 1976  
Application for plugging filed 10/10 1976  
Application for plugging approved 10/10 1976  
Plugging commenced 10/10 1976  
Plugging completed 10/10 1976  
Reason for abandonment of well or producing formation Dry Hole

If a producing well is abandoned, date of last production 19  
Was permission obtained from the Conservation Division or its agents before plugging was commenced? Yes

Name of Conservation Agent who supervised plugging of this well G. I. Biberstein  
Producing formation \_\_\_\_\_ Depth to top \_\_\_\_\_ Bottom \_\_\_\_\_ Total Depth of Well 4,751 Feet  
Show depth and thickness of all water, oil and gas formations.

OIL, GAS OR WATER RECORDS

CASING RECORD

FORMATION	CONTENT	FROM	TO	SIZE	PUT IN	PULLED OUT

Describe in detail the manner in which the well was plugged, indicating where the mud fluid was placed and the method or methods used in introducing it into the hole. If cement or other plugs were used, state the character of same and depth placed, from \_\_\_\_\_ feet to \_\_\_\_\_ feet for each plug set.

360' - 260' 35 sx regular cement  
40' - 0 15 sx regular cement  
Mouse-hole & Rat-hole 5 sx

RECEIVED  
STATE CORPORATION COMMISSION

OCT 13 1976 10-13-76

CONSERVATION DIVISION  
Wichita, Kansas

(If additional description is necessary, use BACK of this sheet)

Name of Plugging Contractor Gabbert & Jones, Inc.  
Address 830 Sutton Place, Wichita, Kansas 67202

STATE OF Kansas COUNTY OF Seward ss.  
I, T. W. Mahoney

(employee of owner) or (owner or operator) of the above-described well, being first duly sworn on oath, says: That I have knowledge of the facts, statements, and matters herein contained and the log of the above-described well as filed and that the same are true and correct. So help me God.

(Signature) T. W. Mahoney  
T. W. Mahoney  
Box 1257, Liberal, Kansas 67901  
(Address)

Subscribed and sworn to before me this 11th day of October, 1976.

My commission expires January 31, 1979

Jolene Dorsett  
Jolene Dorsett Notary Public.



