

STATE OF KANSAS  
STATE CORPORATION COMMISSION


15-151-20508-0000

WELL PLUGGING RECORD

Give All Information Completely  
Make Required Affidavit  
Mail or Deliver Report to  
Conservation Division  
State Corporation Comm.  
245 North Water  
Wichita, KS 67202

Pratt County, Sec. 35 Twp. 28S Rge. 13WE/W  
Location as "NE/CNW $\frac{1}{4}$ SW $\frac{1}{4}$ " or footage from lines  
SE NW SE

Lease Owner Mohawk Energy Corp.  
Lease Name Peachey Well No. 1  
Office Address 2401 Fourth Nat'l. Bank Bldg., Tulsa, Ok. 74119  
Character of Well (Completed as Oil, Gas or Dry Hole)

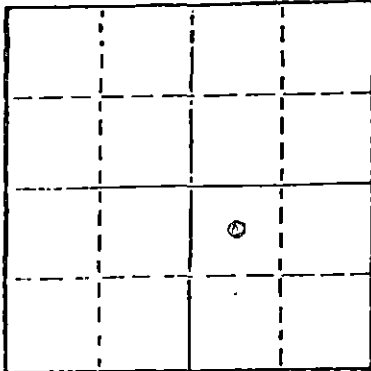

Locate well correctly on above  
Section Plat

Dry Hole  
Date Well completed 6-15-78 19 78  
Application for plugging filed 6-15-78 19 78  
Application for plugging approved          19           
Plugging commenced 6-15-78 19 78  
Plugging completed 6-15-78 19 78  
Reason for abandonment of well or producing formation

Non productive  
If a producing well is abandoned, date of last production 19         

Was permission obtained from the Conservation Division or its agents before plugging was commenced? Yes

Name of Conservation Agent who supervised plugging of this well William T. Owen  
Producing formation None Depth to top          Bottom          Total Depth of Well 4657'  
Show depth and thickness of all water, oil and gas formations.

OIL, GAS OR WATER RECORDS

CASING RECORD

FORMATION	CONTENT	FROM	TO	SIZE	PUT IN	PULLED OUT
		0	731	8-1/8	731	None

Describe in detail the manner in which the well was plugged, indicating where the mud fluid was placed and the method or methods used in introducing it into the hold. If cement or other plugs were used, state the character of same and depth placed, from          feet to          feet for each plug set.  
720' with 50 sacks  
40' bridge and plug with 12 sacks  
3 sacks rathole

RECEIVED  
STATE CORPORATION COMMISSION  
6-23-78

(If additional description is necessary, use BACK of this sheet)

Name of Plugging Contractor Gabbert Jones

STATE OF Oklahoma COUNTY OF Tulsa, ss.  
Troy Mahoney, Operator (employee of owner) or (owner or operator)  
of the above-described well, being first duly sworn on oath, says: That I have knowledge of the facts, statements, and matters herein contained and the log of the above-described well as filed and that the same are true and correct. So help me God.

(Signature) T. W. Mahoney  
(Address)         

SUBSCRIBED AND SWORN TO before me this 21<sup>st</sup> day of June, 19 78

Quentin M. Bryan  
Notary Public.

My commission expires May 28, 1980

GABBERT-JONES, INC.  
 WICHITA, KANSAS  
 DRILLERS' WELL LOG

15451-76508-0000

Peachy #1  
 SE-NW-SE Sec 35-<sup>28</sup>326-13W  
 Pratt County Kansas.

Commenced: 6-1-78

Completed: 6-15-78

OPERATOR: MOHAWK ENERGY CORP.

Depth From	to	Formation	Remarks
0	230	Surface Clay-Sand	Ran 18 jts of 20# 8 5/8" csg
230	795	Redbed	set @ 731' Cemented w/
795	1590	Shale	275 sks Howcolite w/1/2# Flocele
1590	2430	Shale-Lime	per sack 3% CC + 150 sks
2430	2780	Lime-Shale	Common 1/2# Flocele per sack
2780	2950	Shale-Lime	3% CC PD @ 5:55 p.m.
2950	3335	Lime-Shale	6-1-78
3335	3339	Lime	
3339	4070	Lime-Shale	
4070	4523	Lime	
4523	4593	Lime-Shert	
4593	4625	Lime	
4625	4657	Sand	
	4657 - TD		DRY & ABANDONED

STATE OF KANSAS )  
 ) SS  
 COUNTY OF SEDGWICK)

I, the undersigned, being duly sworn on oath, state that the above  
 Drillers' Well Log is true and correct to the best of my knowledge and belief and  
 according to the records of this office.

GABBERT-JONES, INC.

*James S. Sutton II*  
 JAMES S. SUTTON II

Subscribed and sworn to before me this 20th day of June, 1978.

*Elizabeth J. Edwards*  
 ELIZABETH J. EDWARDS-NOTARY PUBLIC

My Commission expires February 6, 1979.



RECORDED  
 STATE OF KANSAS  
 JUN 25 1978