


STATE OF KANSAS
STATE CORPORATION COMMISSION
Give All Information Completely
Make Required Affidavit
Mail or Deliver Report to:
Conservation Division
State Corporation Commission
800 Bittling Building
Wichita, Kansas

WELL PLUGGING RECORD

FORMATION PLUGGING RECORD

Strike out upper line when reporting plugging off formations.

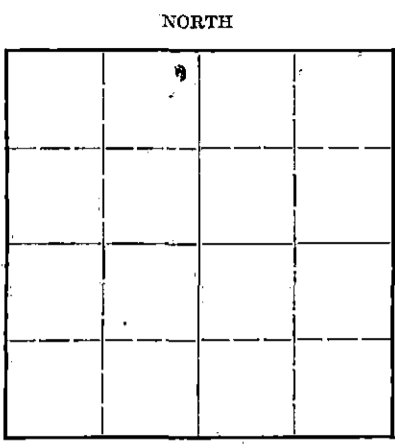

Locate well correctly on above Section Plat

Pratt County. Sec. 33 Twp. 28 Rge. ~~25~~ 13 (W)
 Location as "NE 1/4 NW 1/4 SW 1/4" or footage from lines. NE NE NW
 Lease Owner. Mid-Continent Petroleum Corporation
 Lease Name. F.E. Fleming Well No. 1
 Office Address. Box 1362, Wichita 1, Kansas
 Character of Well (completed as Oil, Gas or Dry Hole). Dry Hole
 Date well completed. March 26, 1948
 Application for plugging filed. Verbal Application, March 26, 1948
 Application for plugging approved. March 26, 1948
 Plugging commenced. March 26, 1948
 Plugging completed. March 26, 1948
 Reason for abandonment of well or producing formation. Dry Hole

If a producing well is abandoned, date of last production. 19____
 Was permission obtained from the Conservation Division or its agents before plugging was commenced? yes

Name of Conservation Agent who supervised plugging of this well. Mr. C.D. Stough.
 Producing formation. None Depth to top. _____ Bottom. _____ Total Depth of Well. 4620' Feet
 Show depth and thickness of all water, oil and gas formations.

OIL, GAS OR WATER RECORDS

CASING RECORD

Formation	Content	From	To	Size	Put In	Pulled Out
Arbuckle Lime	Dry	4553'	4620'	8 5/8"	753'	none

Describe in detail the manner in which the well was plugged, indicating where the mud fluid was placed and the method or methods used in introducing it into the hold. If cement or other plugs were used, state the character of same and depth placed, from _____ feet to _____ feet for each plug set.

Hole filled with heavy mud from 4620' to 750'. Wooden plug drove to 750' and hole filled with 25 sacks of cement through drill pipe from 750' to 699'. Hole filled with heavy mud from 699' to 200'. Wooden plug drove to 200' and cemented through drill pipe with 10 sacks of cement from 200' to 166'. Hole filled with heavy mud from 166' to 40'. Cemented with 10 sacks of cement from 40' to 6'. (Bottom of Cellar) Cellar to be filled to ground level.

Approved
Reed Snyder
3-31-48.

(If additional description is necessary, use BACK of this sheet)

Correspondence regarding this well should be addressed to Mr. Lloyd Snyder.
 Address. Box 1362, Wichita 1, Kansas.

STATE OF Kansas, COUNTY OF Barton, ss.
A.E. Johnson (employee of owner) or (owner) of the above-described well,

being first duly sworn on oath, says: That I have knowledge of the facts, statements, and matters herein contained and the log of the above-described well as filed and that the same are true and correct. So help me God.

(Signature) A.E. Johnson

R.R. # 1, Ellinwood, Kansas.
 (Address)

SUBSCRIBED AND SWORN to before me this 30th. day of March, 1948

My commission expires Oct-28-1948

Reed Snyder
 Notary Public.

MAR 31 1948

20-1300-s **PLUGGING**
 FILE NO. 33-78R13W
 BOOK PAGE 19 LINE 77

3-31-48

15-151-66106-0000

COMPANY - Mid-Continent Petroleum Corp.
FARM - F. E. Fleming No. 1

Sec. 33 T. 28S R. 13W
NE NE NW

Total Depth - 4620'
Comm. 3-1-48 Comp. 3-26-48
Shot or treated
Contractor - Barnett Drilling, Inc.

COUNTY - Pratt

Elevation 1951

CASING:
8 5/8" 24# S.H.L.W. 772'

Production Dry

Surface clay	0	25
Water Sand	25	35
Shale	35	90
Water gravel	90	195
Red bed	195	330
Red bed, shale & shells	330	525
Red bed & shells	525	665
Red bed	665	755
Lime, anhydrite	755	775
Sgale	775	855
Red bed, shale & shells	855	1185
Shale & shells	1185	1215
Shale, salt & shells	1215	1445
Shale & shells	1445	1750
Shale & lime	1750	1880
Lime	1880	2125
Lime & shale	2125	2205
Sandy lime & shale	2205	2280
Shale & lime	2280	2845
Shale	2845	2945
Shale & lime	2945	3205
Lime	3205	3230
Shale & lime	3230	3525
Lime	3525	3815
Lime & shale	3815	3939
Lime, lansing	3939	4320
Lime & chert	4320	4340
Shale & chert	4340	4379
Lime, Mississippi	4379	4405
Shale	4405	4430
Lime, Viola	4430	4468
Shale & sand Simpson	4468	4481
Sand, Simpson	4481	4503
Shale & lime	4503	4541
Dolomite Simpson	4541	4553
Lime, Arbuckle	4553	4620
TOTAL DEPTH	4620	

SCHLUMBERGER TOPS

Lansing Lime	3939
Mississippi Lime	4379
Viola Lime	4430
Simpson shale	4468
Simpson sand	4481
Simpson dolomite	4541
Arbuckle lime	4553 - 4620

PLUGGING
 FILE SEC 33 T 28 R 13W
 BOOK PAGE 19 LINE 27

MAR 31 1948