


Give All Information Completely  
Make Required Affidavit  
Mail or Deliver Report to:  
Conservation Division  
State Corporation Commission  
212 North Market, Insurance Bldg.  
Wichita, Kansas

# WELL PLUGGING RECORD

15-151-19109-0000

NORTH

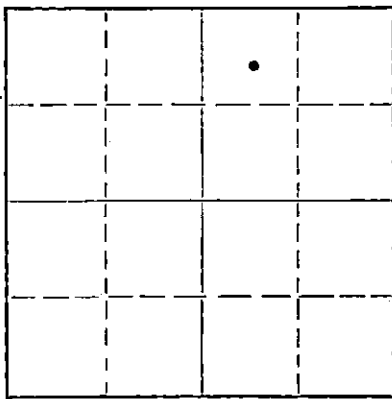

Locate well correctly on above  
Section Plat

Pratt County. Sec. 31 Twp. 28S Rge. (E) 13(W)  
Location as "NE/CNW&SW" or footage from lines C-NW-NE-NE  
Lease Owner Amerada Petroleum Corporation  
Lease Name Mary Moore Well No. 1  
Office Address Box 197, Great Bend, Kansas  
Character of Well (completed as Oil, Gas or Dry Hole) Dry Hole  
Date well completed 9-29- 19 62  
Application for plugging filed 9-28- 19 62  
Application for plugging approved 9-28- 19 62  
Plugging commenced 4:30 p.m. 9-29- 19 62  
Plugging completed 6:00 p.m. 9-29- 19 62  
Reason for abandonment of well or producing formation Dry and Abandoned

If a producing well is abandoned, date of last production - 19  
Was permission obtained from the Conservation Division or its agents before plugging was commenced? Yes

Name of Conservation Agent who supervised plugging of this well Herman Justus, Nickerson, Kansas  
Producing formation - Depth to top - Bottom - Total Depth of Well 4568 Feet  
Show depth and thickness of all water, oil and gas formations.

## OIL, GAS OR WATER RECORDS

## CASING RECORD

FORMATION	CONTENT	FROM	TO	SIZE	PUT IN	PULLED OUT
				8-5/8"	355'	None

Describe in detail the manner in which the well was plugged, indicating where the mud fluid was placed and the method or methods used in introducing it into the hole. If cement or other plugs were used, state the character of same and depth placed, from feet to feet for each plug set.

Filled hole with Heavy Mud from 4568' to 250'  
Spotted Plug from 250' to 185' W/20 Sacks Cement  
Filled hole with heavy mud from 185' to 35'  
Spotted plug from 35' to Top W/15 Sacks Cement

RECEIVED  
STATE CORPORATION COMMISSION

OCT 1 - 1962

CONSERVATION DIVISION  
WICHITA, KANSAS

10-1-62

(If additional description is necessary, use BACK of this sheet)

Name of Plugging Contractor Amerada Petroleum Corporation  
Address Box 197, Great Bend, Kansas

STATE OF Kansas, COUNTY OF Barton, ss.  
A.D. Simpson (employee of owner) or (owner's representative) of the above-described well, being first duly sworn on oath, says: That I have knowledge of the facts, statements, and matters herein contained and the log of the above-described well as filed and that the same are true and correct. So help me God.

(Signature) A.D. Simpson - Foreman  
Box 197, Great Bend, Kansas  
(Address)

SUBSCRIBED AND SWORN TO before me this 10th day of October, 19 62

My commission expires November 21, 1965

Charles W. Anderson

Notary Public.

15-151-<sup>19109</sup>~~6000~~-60-00

MARY MOORE #1

NW NE NE Section 31-28S-13W  
Pratt County, Kansas  
Amerada Petroleum Corporation

8-5/8" O. D. casing cemented at 355'

Drilling commenced 9-15-62  
Drilling completed 9-29-62

0'	40'	Surface clay
40	70	Clay & shells
70	190	Sand
190	358	Red bed
358	900	Red bed & shale
900	1255	Shale & shells
1255	1760	Shale & lime streaks
1760	1945	Shale & lime
1945	2818	Lime & shale
2818	3300	Shale & lime
3300	3610	Lime & shale
3610	3685	Lime
3685	3830	Lime & shale
3830	3930	Shale & lime
3930	4415	Lime
4415	4472	Lime & shale
4472	4523	Lime & chert
4523	4568	Shale & lime

8-5/8" O. D. casing  
cemented with 250 sacks  
at 355'

Well plugged

T. D. 4568'

RECEIVED  
STATE CORPORATION COMMISSION  
OCT 12 1962  
CONSERVATION DIVISION  
Wichita, Kansas