

15-151-60405-0000

STATE OF KANSAS  
STATE CORPORATION COMMISSION

WELL PLUGGING RECORD

Give All Information Completely  
Make Required Affidavit  
Mail or Deliver Report to  
Conservation Division  
State Corporation Commission  
800 Biting Building  
Wichita, Kansas

Pratt County, Sec. 31 Twp. 28S Rge. 13 (E) (W)

Location as "NE/CNW%SW%" or footage from lines SW/4 SW/4 SW/4

Lease Owner Braden Drilling, Inc.

Lease Name Hertlein Well No. 1

Office Address 1206 Union National Building, Wichita 2, Kansas

Character of Well (completed as Oil, Gas or Dry Hole) Dry Hole

Date well completed 4-7-60 19

Application for plugging filed 4-7-60 19

Application for plugging approved 4-7-60 19


Plugging commenced 4-7-60 19

Plugging completed 4-7-60 19

Reason for abandonment of well or producing formation Dry

If a producing well is abandoned, date of last production 19

Was permission obtained from the Conservation Division or its agents before plugging was commenced? Yes

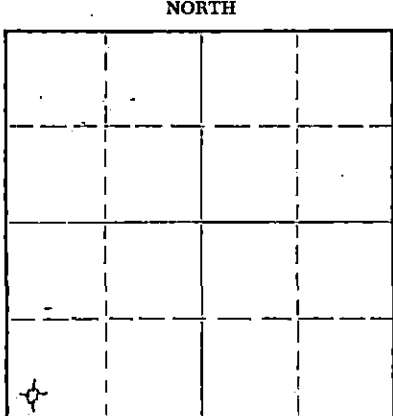

Locate well correctly on above Section Plat

Name of Conservation Agent who supervised plugging of this well Fred Hampel

Producing formation \_\_\_\_\_ Depth to top \_\_\_\_\_ Bottom \_\_\_\_\_ Total Depth of Well 4673 Feet

Show depth and thickness of all water, oil and gas formations.

OIL, GAS OR WATER RECORDS

CASING RECORD

FORMATION	CONTENT	FROM	TO	SIZE	PUT IN	PULLED OUT
				8 5/8	331.88	None

Describe in detail the manner in which the well was plugged, indicating where the mud fluid was placed and the method or methods used in introducing it into the hole. If cement or other plugs were used, state the character of same and depth placed, from \_\_\_\_\_ feet to \_\_\_\_\_ feet for each plug set.

Ran pipe in hole - layed same down - Plug and 20 sacks cement at 300 ft.  
Heavy mud - plug and 10 sacks at 35 ft.

RECEIVED  
STATE CORPORATION COMMISSION

APR 14 1960 4-14-60

CONSERVATION DIVISION  
Wichita, Kansas

(If additional description is necessary, use BACK of this sheet)

Name of Plugging Contractor Braden Drilling, Inc.

Address 1206 Union National Building, Wichita 2, Kansas

STATE OF Kansas, COUNTY OF Sedgwick, ss.

F. M. Callaway (employee of owner) or (owner or operator) of the above-described well, being first duly sworn on oath, says: That I have knowledge of the facts, statements, and matters herein contained and the log of the above-described well as filed and that the same are true and correct. So help me God.

(Signature) [Signature]

1206 Union National Building  
(Address)

SUBSCRIBED AND SWORN TO before me this 13th day of April, 19 60

My commission expires August 22, 1961

[Signature]  
Notary Public.



15-151-60405-0000

DRILLER'S LOG

Braden Drilling, Inc., et al  
HERTLEIN #1  
SW SW SW Sec.31-28S-13W  
Pratt County, Kansas

Commenced: March 14, 1960  
Completed: April 6, 1960

Set 331.88 ft. of 8 5/8 surface casing.  
Cemented with 350 sacks cement.

Clay	40 Feet
Shale & clay	100
Sand & shells	200
Clay, shale	500
Shale and red bed	950
Shale and shells	1140
Shale, salt & shells	1300
Shale & shells	1565
Lime & shale	2040
Lime	2145
Lime & shale	2400
Lime	2550
Shale & lime	3170
Lime	3230
Sandy lime	3950
Lime	3970
Cherty lime & shale	4450
Lime & shale	4515
Lime - Simpson	4547
Lime & shale	4565
Lime	4580
Shale	4640
Lime	4673 Total Depth

RECEIVED  
STATE CORPORATION COMMISSION

APR 14 1960

CONSERVATION DIVISION  
Wichita, Kansas

I, F. M. Callaway, hereby certify that this is a true and correct log of the above captioned well, as shown by the daily drilling reports.

BRADEN DRILLING, INC.

  
\_\_\_\_\_  
F. M. Callaway

Subscribed and sworn to before me this 13th day of April, 1960

My commission expires August 22, 1961

  
\_\_\_\_\_  
Gladys Treanary, Notary Public