

STATE OF KANSAS
STATE CORPORATION COMMISSION


Form CP-4

WELL PLUGGING RECORD

Give All Information Completely
Make Required Affidavit
Mail or Deliver Report to:
Conservation Division
State Corporation Commission
211 No. Broadway
Wichita, Kansas

Pratt County. Sec. 31 Twp. 28 Rge. (E)13 (W)
Location as "NE/CNWSW" or footage from lines. NW NW NE
Lease Owner Pickrell Drilling Company
Lease Name Moore "C" Well No. 1
Office Address 705 4th National Bank Bldg, Wichita 2, Kansas
Character of Well (completed as Oil, Gas or Dry Hole) Dry Hole
Date well completed September 23, 1963
Application for plugging filed September 23, 1963
Application for plugging approved September 23, 1963
Plugging commenced September 23, 1963
Plugging completed September 23, 1963
Reason for abandonment of well or producing formation Dry Hole

NORTH

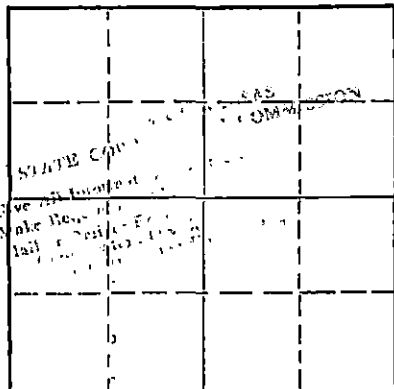

Locate well correctly on above
Section Plat

If a producing well is abandoned, date of last production 19
Was permission obtained from the Conservation Division or its agents before plugging was commenced? Yes

Name of Conservation Agent who supervised plugging of this well Fred Hampel
Producing formation _____ Depth to top _____ Bottom _____ Total Depth of Well 4557 Feet
Show depth and thickness of all water, oil and gas formations.

OIL, GAS OR WATER RECORDS

CASING RECORD

FORMATION	CONTENT	FROM	TO	SIZE	PUT IN	PULLED OUT
				8 5/8"	317'	None

Describe in detail the manner in which the well was plugged, indicating where the mud fluid was placed and the method or methods used in introducing it into the hole. If cement or other plugs were used, state the character of same and depth placed, from _____ feet to _____ feet for each plug set.

Heavy mud to 300'. Set plug. Cemented with
25 sacks cement. Heavy mud to 40'. Set plug.
Cemented with 10 sacks cement to bottom of
cellar. Plugged rat hole with 2 sacks cement.

RECEIVED
STATE CORPORATION COMMISSION

10-28-63 OCT 28 1963

CONSERVATION DIVISION
Wichita, Kansas

(If additional description is necessary, use BACK of this sheet)
Name of Plugging Contractor PICKRELL DRILLING COMPANY
Address 705 4th Natl Bank Bldg, Wichita 2, Kansas

STATE OF KANSAS, COUNTY OF SEDGWICK, ss.

C. W. SEBITS (owner or operator) of the above-described well, being first duly sworn on oath, says: That I have knowledge of the facts, statements, and matters herein contained and the log of the above-described well as filed and that the same are true and correct. So help me God.

(Signature) C. W. Sebitts
705 4th Natl Bank Bldg, Wichita 2, Kansas
(Address)

SUBSCRIBED AND SWORN to before me this 25th day of SEPTEMBER, 1963

My commission expires June 21, 1966

Maxine Blackman
Notary Public

ROTARY DRILLING LOG

15-151-10001-0000

COMPANY: PICKRELL DRILLING COMPANY
705 4th Natl Bank Bldg
Wichita 2, Kansas
Rotary Drilling Commenced 9-10-63
Rotary Drilling Completed 9-23-63
LOCATION: Moore "C" No. 1 - NW NW NE 31-28S-13W,
Pratt County, Kansas
CONTRACTOR: PICKRELL DRILLING COMPANY
Wichita, Kansas
CASING RECORD: (13 jts) 8 5/8" surface casing set at 317', cemented with 225
sacks cement. Circulated. Completed 5:15 P.M. September 10,
1963. No oil string run, D & A.

LOG

(Figures indicate bottom of formation — measurements from top of rotary bushing.)

Table with 3 columns: Depth (feet), Formation, and C.F.S. (Cement Feet Surface). Rows include Clay, Sand, Red Bed, Red Bed & Shale, Shale & Shells, Lime, Lime & Shale, and Chert & Shale.

Slope Test table with 2 columns: Depth (feet) and Slope Test. Values range from 2500 to 4000.

S. L. M. table with 2 columns: Depth (feet) and S. L. M. Values range from 3815 to 4402.

RECEIVED
STATE CORPORATION COMMISSION

OCT 28 1963

CONSERVATION DIVISION
Wichita, Kansas

The undersigned, C. W. SEBITS, Attorney-in-Fact for PICKRELL DRILLING COMPANY, hereby certifies in behalf of said Company, that the above is a true and correct log of the formation encountered in drilling the above well as reflected by the Daily Drilling Reports.

PICKRELL DRILLING COMPANY
By: [Signature]
C. W. SEBITS Attorney-in-Fact

STATE OF KANSAS
COUNTY OF SEDGWICK } ss.

On this 25th day of SEPTEMBER, 19 63, before me the undersigned, a Notary Public, in and for the County and State aforesaid, personally appeared G. W. SEBITS, to me known to be the identical person who subscribed the name of PICKRELL DRILLING COMPANY to the foregoing instrument as its Attorney-in-Fact and acknowledged to me that he executed the same as his free and voluntary act and deed, and as the free and voluntary act and deed of such company, for the uses and purposes therein set forth.

Given under my hand and seal of office the day and year last above written.

My commission expires: June 21, 1966

[Signature]
Maxine Blackman Notary Public