

15-151-20663-0000

STATE OF KANSAS  
STATE CORPORATION COMMISSION

WELL PLUGGING RECORD

Give All Information Completely  
Make Required Affidavit  
Mail or Deliver Report to  
Conservation Division  
State Corporation Comm.  
245 North Water  
Wichita, KS 67202

Pratt County, Sec. 21 Twp. 28S Rge. 13 ~~EW~~W  
Location as "NE/CNW $\frac{1}{4}$ /SW $\frac{1}{4}$ " or footage from lines \_\_\_\_\_

C NW SW

Lease Owner Mid-Continent Energy Corp.  
Lease Name Banbury Well No. 1  
Office Address One Twenty Bldg., #712, Wichita, Kansas 67202  
Character of Well (Completed as Oil, Gas or Dry Hole) \_\_\_\_\_


Dry Hole

Date Well completed September 9, 1979  
Application for plugging filed September 9, 1979  
Application for plugging approved September 9, 1979  
Plugging commenced September 9, 1979  
Plugging completed September 9, 1979  
Reason for abandonment of well or producing formation \_\_\_\_\_

If a producing well is abandoned, date of last production \_\_\_\_\_ 19\_\_\_\_

Was permission obtained from the Conservation Division or its agents before plugging was commenced? Yes

Name of Conservation Agent who supervised plugging of this well Wm. T. Owen, Pratt, Kansas  
Producing formation \_\_\_\_\_ Depth to top \_\_\_\_\_ Bottom \_\_\_\_\_ Total Depth of Well 3989'  
Show depth and thickness of all water, oil and gas formations.

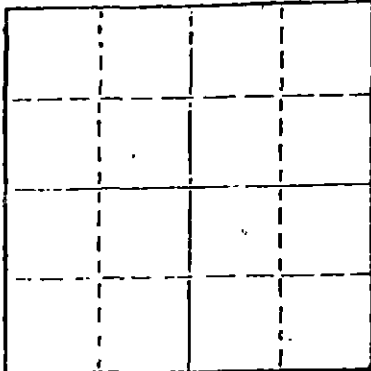

Locate well correctly on above Section Plat

OIL, GAS OR WATER RECORDS

CASING RECORD

FORMATION	CONTENT	FROM	TO	SIZE	PUT IN	PULLED OUT
				10-3/4"	252'	None

Describe in detail the manner in which the well was plugged, indicating where the mud fluid was placed and the method or methods used in introducing it into the hold. If cement or other plugs were used, state the character of same and depth placed, from \_\_\_\_\_ feet to \_\_\_\_\_ feet for each plug set.

Pumped 40 sacks cement through drill pipe to 540 feet. Pumped 40 sacks cement through drill pipe to 258 feet. Pushed plug and 1/2 sack hulls to 40 feet and pumped 15 sacks cement through drill pipe with pump truck to base of well cellar. Plugged rat hole with 3 sacks cement. Plugged water well with 2 sacks cement.

RECEIVED  
STATE CORPORATION COMMISSION

SEP 17 1979 9-17-79

CONSERVATION DIVISION  
Wichita, Kansas

(If additional description is necessary, use BACK of \_\_\_\_\_ sheet)

Name of Plugging Contractor Graves Drilling Co., Inc.

STATE OF KANSAS COUNTY OF SEDGWICK, ss.

Betty Brandt (employee of owner) or (owner or operator)

of the above-described well, being first duly sworn on oath, says: That I have knowledge of the facts, statements, and matters herein contained and the log of the above-described well as filed and that the same are true and correct. So help me God.

(Signature)

Betty Brandt

910 Union Center, Wichita, Kansas 67202

(Address)

SUBSCRIBED AND SWORN TO before me this 14th day of September, 19 79

Rebecca L. Matthews

Rebecca L. Matthews

Notary Public.

My commission expires May 17, 1983

R O T A R Y D R I L L E R S ' L O G

OPERATOR: Mid-Continent Energy Corp.  
Suite 712, One Twenty Building  
Wichita, Kansas 67202

COMMENCED: August 29, 1979

CONTRACTOR: Graves Drilling Co., Inc.  
910 Union Center  
Wichita, Kansas 67202

COMPLETED: September 9, 1979

CASING RECORD: 6 Jts. 252' of new 10-3/4"  
cemented with 225 sacks

LOCATION: Banbury No. 1  
C NW SW  
Section 21-28S-13W  
Pratt County, Kansas

-----

0 - 207	Sand
207 - 980	Red Bed
980 - 1433	Shale & shells
1433 - 3920	Shale & lime
3920 - 3989	Lime & shale
3989	Rotary Total Depth

I hereby certify the foregoing statements to be true and correct to the best of my knowledge.

GRAVES DRILLING CO., INC.

By Rebecca J. Boardman  
Secretary-Treasurer

RECEIVED  
STATE CORPORATION COMMISSION  
SEP 17 1979  
Wichita, Kansas

STATE OF KANSAS )  
                          )     ss.  
SEDGWICK COUNTY )

Subscribed and sworn to before me, a Notary Public, this 14th day of September, 1979.

Rebecca L. Matthews  
Rebecca L. Matthews     Notary Public

My commission expires: May 17, 1983