


15-097-10068-0068

STATE OF KANSAS
STATE CORPORATION COMMISSION

WELL PLUGGING RECORD

Give All Information Completely
Make Required Affidavit
Mail or Deliver Report to:
Conservation Division
State Corporation Commission
211 No. Broadway
Wichita, Kansas

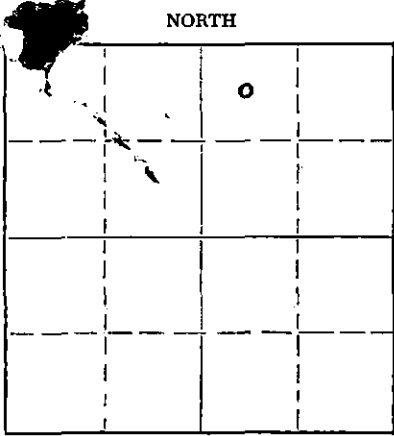

Locate well correctly on above
Section Plat

Kiowa County, Sec. 27 Twp. 29S Rge. 18(W)
Location as "NE/CNW/SW" or footage from lines 654' EWL and 669' SNL
Lease Owner Gulf Oil Corporation
Lease Name N. Mathis Well No. 1
Office Address Box 661, Tulsa, Oklahoma
Character of Well (completed as Oil, Gas or Dry Hole) Dry Hole
Date well completed 3-21 19 57
Application for plugging filed 5-20 19 57
Application for plugging approved 5-21 19 57
Plugging commenced 5-21 19 57
Plugging completed 5-21 19 57
Reason for abandonment of well or producing formation Dry Hole

If a producing well is abandoned, date of last production 19
Was permission obtained from the Conservation Division or its agents before plugging was commenced? Yes

Name of Conservation Agent who supervised plugging of this well M. A. Rives
Producing formation _____ Depth to top _____ Bottom _____ Total Depth of Well 5063 Feet
Show depth and thickness of all water, oil and gas formations.

OIL, GAS OR WATER RECORDS

CASING RECORD

FORMATION	CONTENT	FROM	TO	SIZE	PUT IN	PULLED OUT
				8-5/8"	371'	0-

Describe in detail the manner in which the well was plugged, indicating where the mud fluid was placed and the method or methods used in introducing it into the hole. If cement or other plugs were used, state the character of same and depth placed, from _____ feet to _____ feet for each plug set.

Filled hole with mud into surface casing and capped with swedge nipple and valve. Well was held in this status from 3-21-57 to 5-21-57. Pumped 100 sacks Pozmix No. 1 into surface casing and then capped with 10 sacks filling hole into base of cellar.

(If additional description is necessary, use BACK of this sheet)

Name of Plugging Contractor Halliburton Oil Well Cementing Company
Address Pratt, Kansas

STATE OF Kansas, COUNTY OF Sedgwick, ss.
Thomas A. Trax (employee of owner) of the above-described well, being first duly sworn on oath, says: That I have knowledge of the facts, statements, and matters herein contained and the log of the above-described well as filed and that the same are true and correct. So help me God.

(Signature) [Signature]
THOMAS A. TRAX, Asst. Zone Supt. of Production
Box 2233, Wichita, Kansas
(Address)

SUBSCRIBED AND SWORN TO before me this 31st day of May, 19 57

My commission expires 2-4-59

[Signature]
RAY W. ROUBER, Notary Public.

:JRM

PLUGGING
FILE SEC 27 29 18W
BOOK PAGE 14 LINE 14

JUN 3 X 1957 6-3-57
CONSERVATION DIVISION
Wichita, Kansas

15-097-10060-0000

WELL LOG

COMPANY: GULF OIL CORPORATION

Sec. 27-29S-18W

FARM: Nellie Mathis No. 1

Loc. NW NE

TOTAL DEPTH - 5063'

County - Kiowa

COMM: 3-3-57. COMP: 3-22-57.

CASING

ELEVATION

8-5/8 - 371'

D.F. -

Gr. -

DRILLER'S LOG

Sand, Clay & Red Bed	0	372
Shale	372	1000
Shale & Lime	1000	4920
Shale, Lime & Chert	4920	4935
Shale & Lime	4935	5063
Total Depth		5063

RECEIVED
STATE CORPORATION

MAY

PLUGGING
 FILE SEC 27 T29 18W
 BOOK PAGE 14 LINE 14


CONSERVATION DIVISION

STATE OF KANSAS
STATE CORPORATION COMMISSION

Give All Information Completely
Make Required Affidavit
Mail or Deliver Report to:
Conservation Division
State Corporation Commission
211 No. Broadway
Wichita, Kansas

WELL PLUGGING RECORD

NORTH

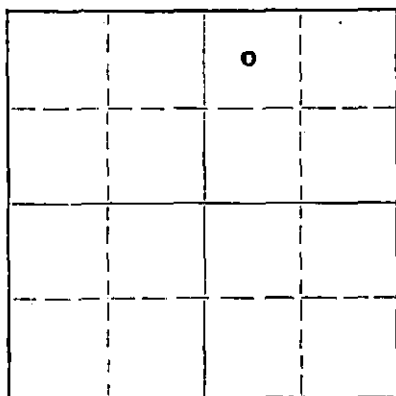

Locate well correctly on above
Section Plat

Kiowa County. Sec. 27 Twp. 29S Rge. 18 (W)
Location as "NE/CNWxSWx" or footage from lines 654' EWL and 669' SNL.
Lease Owner Gulf Oil Corporation
Lease Name N. Mathis Well No. 1
Office Address Box 661, Tulsa, Oklahoma
Character of Well (completed as Oil, Gas or Dry Hole) Dry Hole
Date well completed 3-21 19 57
Application for plugging filed 5-20 19 57
Application for plugging approved 5-21 19 57
Plugging commenced 5-21 19 57
Plugging completed 5-21 19 57
Reason for abandonment of well or producing formation Dry Hole

If a producing well is abandoned, date of last production _____ 19____
Was permission obtained from the Conservation Division or its agents before plugging was commenced? Yes

Name of Conservation Agent who supervised plugging of this well M. A. Rives
Producing formation _____ Depth to top _____ Bottom _____ Total Depth of Well 5063 Feet
Show depth and thickness of all water, oil and gas formations.

OIL, GAS OR WATER RECORDS

CASING RECORD

FORMATION	CONTENT	FROM	TO	SIZE	PUT IN	PULLED OUT
				8-5/8"	371'	-0-

Describe in detail the manner in which the well was plugged, indicating where the mud fluid was placed and the method or methods used in introducing it into the hole. If cement or other plugs were used, state the character of same and depth placed, from _____ feet to _____ feet for each plug set.

Filled hole with mud into surface casing and capped with swedge nipple and valve. Well was held in this status from 3-21-57 to 5-21-57. Pumped 100 sacks Pozmix No.1 into surface casing and then capped with 10 sacks filling hole into base of cellar.

(If additional description is necessary, use BACK of this sheet)

Name of Plugging Contractor Halliburton Oil Well Cementing Company
Address Pratt, Kansas

STATE OF Kansas, COUNTY OF Sedgwick, ss.
Thomas A. Trax (employee of owner) of the above-described well, being first duly sworn on oath, says: That I have knowledge of the facts, statements, and matters herein contained and the log of the above-described well as filed and that the same are true and correct. Help me God

(Signature) [Signature]
THOMAS A. TRAX, Asst. Zone Supt. of Production
Box 2233, Wichita, Kansas
(Address)

SUBSCRIBED AND SWORN TO before me this 31st day of May, 19 57

My commission expires 2-4-59

[Signature]
RAY W. ROUBIN, Notary Public.

:JRM

PLUGGING
FILE SEC 27 T. 29. R18W
BOOK PAGE 14 LINE 14

JUN 3 X 1957
CONSERVATION DIVISION
Wichita, Kansas

WELL LOG

COMPANY: GULF OIL CORPORATION

Sec. 27-29S-18W

FARM: Nellie Mathis No. 1

Loc. NW NE

TOTAL DEPTH - 5063'

County - Kiowa

COMM: 3-3-57. COMP: 3-22-57.

CASING

ELEVATION

8-5/8 - 371'

D.P. -
Gr. -

DRILLER'S LOG

Sand, Clay & Red Bed	0	372
Shale	372	1000
Shale & Lime	1000	4920
Shale, Lime & Chert	4920	4935
Shale & Lime	4935	5063
 Total Depth		 5063

RECEIVED
STATE CORPORATION COMMISSION

MAY 2 1957

PLUGGING
 FILE SEC. 27 T. 29 18W
 BOOK PAGE 14 LINE 14

CONSERVATION DIVISION
Wichita, Kansas