

STATE OF KANSAS  
STATE CORPORATION COMMISSION

Form CP-4

Give All Information Completely  
Make Required Affidavit  
Mail or Deliver Report to:  
Conservation Division  
State Corporation Commission  
212 No. Market  
Wichita, Kansas 67202


WELL PLUGGING RECORD

Kiowa County, Sec. 27 Twp. 29 Rge. (E) 18 (W)  
Location as "NE/CNW&SW4" or footage from lines C SW NW  
Lease Owner Misco Supply Company  
Lease Name Rodger Schmidt Well No. 1  
Office Address 257 N. Broadway, Wichita, Kansas  
Character of Well (completed as Oil, Gas or Dry Hole) oil  
Date well completed \_\_\_\_\_ 19\_\_\_\_  
Application for plugging filed June 15 19 71  
Application for plugging approved \_\_\_\_\_ 19\_\_\_\_  
Plugging commenced June 26 19 71  
Plugging completed July 2 19 71  
Reason for abandonment of well or producing formation depleted

If a producing well is abandoned, date of last production \_\_\_\_\_ 19\_\_\_\_  
Was permission obtained from the Conservation Division or its agents before plugging was commenced? YES

Name of Conservation Agent who supervised plugging of this well G. R. Biberstein  
Producing formation \_\_\_\_\_ Depth to top \_\_\_\_\_ Bottom \_\_\_\_\_ Total Depth of Well 5095 Feet

Show depth and thickness of all water, oil and gas formations.

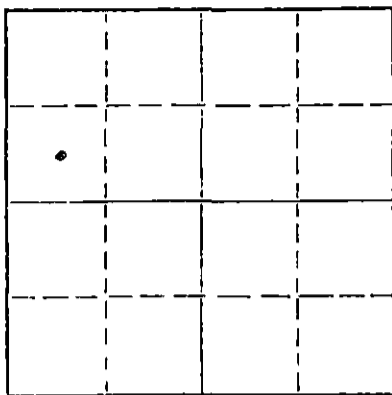

Locate well correctly on above Section Plat

OIL, GAS OR WATER RECORDS

CASING RECORD

FORMATION	CONTENT	FROM	TO	SIZE	PUT IN	PULLED OUT
		0	413.50	8 5/8"	413.50	none
		0	5094'	5 1/2"	5094'	3526.22

Describe in detail the manner in which the well was plugged, indicating where the mud fluid was placed and the method or methods used in introducing it into the hole. If cement or other plugs were used, state the character of same and depth placed, from \_\_\_\_\_ feet to \_\_\_\_\_ feet for each plug set.

Sanded back to 5000' and dumped 5 sacks of cement.

Set 20' rock bridge at 300'. Plugged well with 5 yards of ready mix cement.

RECEIVED  
STATE CORPORATION COMMISSION  
JUL 14 1971  
CONSERVATION DIVISION  
Wichita, Kansas

7-14-71

(If additional description is necessary, use BACK of this sheet)  
Name of Plugging Contractor PIPE PULLERS, INC.  
Address Box 486, Ellinwood, Kansas

STATE OF KANSAS, COUNTY OF BARTON, SS.  
Evelyn Roth (employee of owner) or (owner or operator) of the above-described well, being first duly sworn on oath, says: That I have knowledge of the facts, statements, and matters herein contained and the log of the above-described well as filed and that the same are true and correct. So help me God.

(Signature) Evelyn Roth  
Ellinwood, Kansas (Address)

SUBSCRIBED AND SWORN to before me this 13th day of July, 19 71

My commission expires Feb. 10, 1975

George A. Meyer  
Notary Public.

15-097-10168-0000  
**COPY**


WELL LOG BUREAU—KANSAS GEOLOGICAL SOCIETY  
 508 East Murdock, Wichita, Kansas

Company- SINCLAIR OIL & GAS CO.  
 Farm- Redger Schmidt No. 1

SEC. 27 T. 29 R. 18W  
 G SW NW

Total Depth. 5095'  
 Comm. 9-13-56 Comp. 10-7-56  
 Shot or Treated.  
 Contractor.  
 Issued. 10-26-57

County Kiowa  
 KANSAS

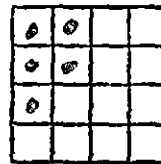

CASING:  
 8 5/8" 413.50'  
 5 1/2" 5094'

Elevation. 2228

Production. 1769 BOPD

Figures indicate Bottom of Formations.

shale-red bed	458
red bed-shells	2369
shale-shells	2459
sdv lime	2539
sdv lime-shale	2606
lime-shale	2652
shale-lime strks	2734
sdv shale-lime	2795
lime-shale	3115
shale	3698
shale-lime	4337
lime	4718
lime-shale	4795
shale	4837
shale-lime	4925
lime	4930
Core #1	4948
Chert	4949
Core #2	4959
Core #3	4960
Core #4	4964
chert	4967
Core #5	4975
Core #6	4987
Core #7	4994
chert	4995
Core #8	5007
chert	5020
lime	5095
Total Depth	

TOPS: Scout	
Heebner	4134
Douglas shale	4166
Douglas sand	4190
Lansing	4322
Mississippi	4927

RECEIVED  
 STATE CORPORATION COMMISSION  
 JUN 16 1971  
 CONSERVATION DIVISION  
 Wichita, Kansas