

STATE OF KANSAS
STATE CORPORATION COMMISSION

Form CP-4


Give All Information Completely
Make Required Affidavit
Mail or Deliver Report to:
Conservation Division
State Corporation Commission
212 No. Market
Wichita, Kansas 67202

WELL PLUGGING RECORD

Kiowa County, Sec. 27 Twp. 29 Rge. (E) 18 (W)

Location as "NE/CNW*SW*" or footage from lines. C NE NW
Lease Owner Misco Supply Company
Lease Name Mollie Greenwood Well No. 3
Office Address 257 N. Broadway, Wichita, Kansas
Character of Well (completed as Oil, Gas or Dry Hole) oil
Date well completed _____ 19____
Application for plugging filed June 15 1971
Application for plugging approved _____ 19____
Plugging commenced July 19 1971
Plugging completed July 21 1971
Reason for abandonment of well or producing formation depleted

If a producing well is abandoned, date of last production _____ 19____
Was permission obtained from the Conservation Division or its agents before plugging was commenced? yes

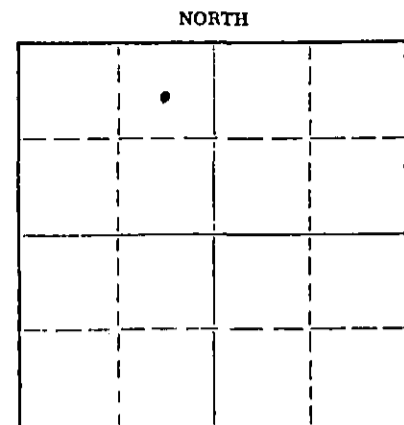

Locate well correctly on above Section Plat

Name of Conservation Agent who supervised plugging of this well G. R. Biberstein
Producing formation _____ Depth to top _____ Bottom _____ Total Depth of Well 4968 Feet
Show depth and thickness of all water, oil and gas formations.

OIL, GAS OR WATER RECORDS

CASING RECORD

FORMATION	CONTENT	FROM	TO	SIZE	PUT IN	PULLED OUT
		0	398'	10 3/4"	398'	none
		0	4965'	5 1/2"	4965'	3320.69

Describe in detail the manner in which the well was plugged, indicating where the mud fluid was placed and the method or methods used in introducing it into the hole. If cement or other plugs were used, state the character of same and depth placed, from _____ feet to _____ feet for each plug set.

Sanded back to 4900' and dumped 5 sacks of cement.

Set 20' rock bridge at 300'. Plugged well with 6 yards of ready mix cement.

RECEIVED
STATE CORPORATION COMMISSION
AUG 12 1971
CONSERVATION DIVISION
Wichita, Kansas

8-12-71

(If additional description is necessary, use BACK of this sheet)
Name of Plugging Contractor PIPE PULLERS, INC.
Address Box 486, Ellinwood, Kansas

STATE OF KANSAS, COUNTY OF BARTON, ss.
Evelyn Roth (employee of owner) or (owner or operator) of the above-described well, being first duly sworn on oath, says: That I have knowledge of the facts, statements, and matters herein contained and the log of the above-described well as filed and that the same are true and correct. So help me God.

(Signature) Evelyn Roth
Ellinwood, Kansas (Address)

SUBSCRIBED AND SWORN to before me this 10th day of August, 19 71

My commission expires July 7, 1972

[Signature]
Notary Public.

WELL LOG BUREAU—KANSAS GEOLOGICAL SOCIETY
508 East Murdock, Wichita, Kansas


15-097-10136-0000
COPY

Company- OHIO OIL CO.
Farm- Mollie Greenwood No. 3

SEC. 27 T. 29 R18W
C NE NW

Total Depth. 4968'
Comm. 1-17-57 Comp. 2-12-56
Shot or Treated.
Contractor. The R.W. Rine Drlg. Co.
Issued. 4-6-57

County Kiowa KANSAS

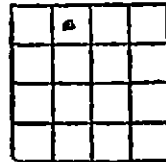

Elevation. 2213' KH

Production. 150 BO & 1 BW &
52,123 CFG in 24 hrs.
flowing.

Figures indicate Bottom of Formations.

surface sand-shale-red bed	0 - 1013
shale-shells	1725
shale-gyp	1950
shale-shells	2208
lime-shale	2445
lime	2535
lime-shale	2753
lime	3202
lime-shale	3272
lime-chalk	3400
lime	3571
lime-shale	3857
lime	3992
lime-shale	3974
lime	4189
lime-shale	4325
lime	4620
lime-shale	4673
lime	4740
lime-chert	4793
lime	4830
lime-chert	4914
chert-chat	4968
Total Depth	

TOPS:

Heebner shale	4123
brown lime	4301
Kansas City lime	4313
Mississippi chert	4909

Treatment: 100 ga ls. mud a cid.

RECEIVED
STATE CORPORATION COMMISSION
JUN 16 1971
CONSERVATION DIVISION
Wichita, Kansas