

STATE OF KANSAS
STATE CORPORATION COMMISSION


Form CP-4

Give All Information Completely
Make Required Affidavit
Mail or Deliver Report to:
Conservation Division
State Corporation Commission
212 No. Market
Wichita, Kansas 67202

WELL PLUGGING RECORD

Kiowa County, Sec. 27 Twp. 29 Rge. (E) 18 (W)

Location as "NE/CNW/SW" or footage from lines C SE NW
Lease Owner Misco Supply Company
Lease Name Mollie Greenwood Well No. 2
Office Address 257 N. Broadway, Wichita, Kansas
Character of Well (completed as Oil, Gas or Dry Hole) oil
Date well completed _____ 19____
Application for plugging filed June 15 1971
Application for plugging approved _____ 19____
Plugging commenced July 14 1971
Plugging completed July 19 1971
Reason for abandonment of well or producing formation depleted

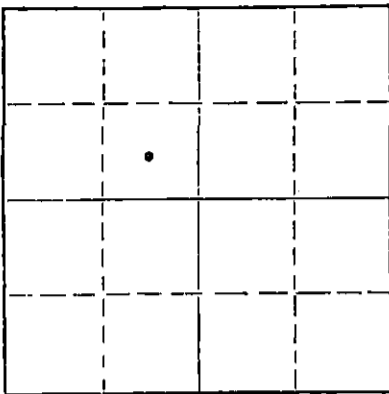

Locate well correctly on above Section Plat

If a producing well is abandoned, date of last production _____ 19____
Was permission obtained from the Conservation Division or its agents before plugging was commenced? yes

Name of Conservation Agent who supervised plugging of this well G. R. Biberstein
Producing formation _____ Depth to top _____ Bottom _____ Total Depth of Well 5085 Feet
Show depth and thickness of all water, oil and gas formations.

OIL, GAS OR WATER RECORDS

CASING RECORD

FORMATION	CONTENT	FROM	TO	SIZE	PUT IN	PULLED OUT
		0	387'	10 3/4"	387'	none
		0	5070'	5 1/2"	5070'	3539.53

Describe in detail the manner in which the well was plugged, indicating where the mud fluid was placed and the method or methods used in introducing it into the hole. If cement or other plugs were used, state the character of same and depth placed, from _____ feet to _____ feet for each plug set.

Sanded back to 5000' and dumped 5 sacks of cement.
Set 20' rock bridge at 300'. Plug well with 6 yards of ready mix cement.

RECEIVED
STATE CORPORATION COMMISSION
AUG 12 1971
CONSERVATION DIVISION
Wichita, Kansas

8-12-71

(If additional description is necessary, use BACK of this sheet)
Name of Plugging Contractor PIPE PULLERS, INC.
Address Box 486, Ellinwood, Kansas

STATE OF KANSAS, COUNTY OF BARTON, ss.
Evelyn Roth (employee of owner) or (~~owner or operator~~) of the above-described well, being first duly sworn on oath, says: That I have knowledge of the facts, statements, and matters herein contained and the log of the above-described well as filed and that the same are true and correct. So help me God.

(Signature) Evelyn Roth
Ellinwood, Kansas (Address)

SUBSCRIBED AND SWORN TO before me this 10th day of August, 1971

My commission expires July 7, 1972

[Signature]
Notary Public.

WELL LOG BUREAU—KANSAS GEOLOGICAL SOCIETY
508 East Murdock,
Wichita, Kansas


15-097-10135-0800
COPY

Company. OHIO OIL CO.
Farm. Mollie Greenwood No. 2

SEC. 27 T. 29 R. 18W
C SE NW

Total Depth. 5085'
Comm. 11-12-56 Comp. 12-15-56
Shot or Treated.
Contractor. R.W. Rine Drlg. Co.
Issued. 2-23-57

County Kiowa
KANSAS

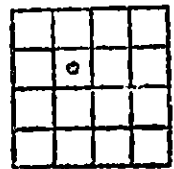

CASING:
10 3/4" 387' w/300 sx cem. Elevation. 2247' KB
5 1/2" 5070' w/250 sx cem. recemented @ 4985' w/200 sx cem.
Production. 324 BOPD

Figures indicate Bottom of Formations.

shale-sand	450
red bed	1021
shale	1185
red bed	1720
shale-shells	2112
shale-shells-sand	2410
lime-shells	2520
lime-shale	2755
lime	2845
lime-shale	2950
lime	3200
lime-shale	3870
lime	4005
lime-shale	4115
lime	4180
lime-shale	4344
lime	4920
lime-chert	5055
lime	5085
Total Depth	

TOPS:
Heebner shale 4160
Lansing Kansas City 4351
Mississippi chert 4992
Mississippi lime 5049

RECEIVED
STATE CORPORATION COMMISSION
JUN 16 1971
CONSERVATION DIVISION
Wichita, Kansas