

STATE OF KANSAS
STATE CORPORATION COMMISSION

Form CP-4


Give All Information Completely
Make Required Affidavit
Mail or Deliver Report to:
Conservation Division
State Corporation Commission
212 No. Market
Wichita, Kansas 67202

WELL PLUGGING RECORD

Kiowa County, Sec. 27 Twp. 29 Rge. (E) 18 (W)

Location as "NE/CNW/SE/SW" or footage from lines CNW NW/4
Lease Owner Misco Supply Company
Lease Name Rodger Schmidt Well No. 2
Office Address 257 N. Broadway, Wichita, Kansas
Character of Well (completed as Oil, Gas or Dry Hole) oil
Date well completed _____ 19____
Application for plugging filed June 15 1971
Application for plugging approved _____ 19____
Plugging commenced June 30 1971
Plugging completed July 6 1971
Reason for abandonment of well or producing formation depleted

If a producing well is abandoned, date of last production _____ 19____
Was permission obtained from the Conservation Division or its agents before plugging was commenced? yes

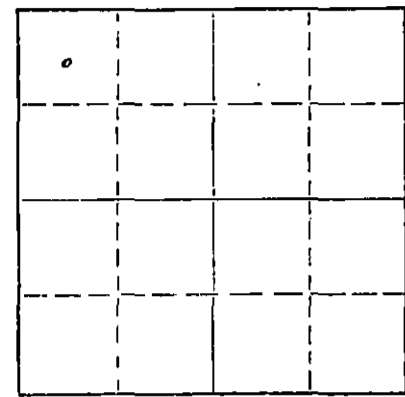

Locate well correctly on above Section Plat

Name of Conservation Agent who supervised plugging of this well G. R. Biberstein
Producing formation _____ Depth to top _____ Bottom _____ Total Depth of Well 5070 Feet
Show depth and thickness of all water, oil and gas formations.

OIL, GAS OR WATER RECORDS

CASING RECORD

FORMATION	CONTENT	FROM	TO	SIZE	PUT IN	PULLED OUT
		0	480'	8 5/8"	480'	none
		0	5070'	5 1/2"	5070'	3129.41

Describe in detail the manner in which the well was plugged, indicating where the mud fluid was placed and the method or methods used in introducing it into the hole. If cement or other plugs were used, state the character of same and depth placed, from _____ feet to _____ feet for each plug set.

Sanded back to 5000' and dumped 5 sacks of cement.

Set 20' rock bridge at 300' and plugged well with 5 yards of ready mix cement.

RECEIVED
STATE CORPORATION COMMISSION
JUL 23 1971
CONSERVATION DIVISION
Wichita, Kansas

7-23-71

(If additional description is necessary, use BACK of this sheet)
Name of Plugging Contractor PIPE PULLERS, INC.
Address Box 486, Ellinwood, Kansas

STATE OF KANSAS, COUNTY OF BARTON, ss.
Evelyn Roth (employee of owner) or (~~owner or operator~~) of the above-described well, being first duly sworn on oath, says: That I have knowledge of the facts, statements, and matters herein contained and the log of the above-described well as filed and that the same are true and correct. So help me God.

(Signature) Evelyn Roth
Ellinwood, Kansas (Address)

SUBSCRIBED AND SWORN to before me this 20th day of July, 1971

My commission expires Feb. 10, 1975

George A. Meyer
Notary Public.

15-097-10169-0000


WELL LOG BUREAU—KANSAS GEOLOGICAL SOCIETY
508 East Murdock, Wichita, Kansas

Company- SINCLAIR OIL & GAS COMPANY
Farm- Redger Schmidt No. 2

SEC. 27 T. 29 R. 18W
CNW NW/4

Total Depth. 5070
Comm. 11-7-56 Comp. 11-28-56
Shot or Treated.
Contractor.
Issued. 1-12-57

County Kiowa KANSAS

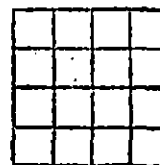

CASING:
8 5/8" 480'
5 1/2" 5070'

Elevation. 2215 RB

Production. 910 bbls & no water

Figures indicate Bottom of Formations.

shale, shells	522
shale	1075
shale, shells	2173
lime, shale	3584
shale	3605
lime, shale	3792
shale	3802
lime, shale	3846
lime	3956
lime, shale	4060
lime	4141
shale sandy	4241
lime, shale	4395
lime	4443
lime, shale	4547
lime	4569
lime, shale, chert	4618
lime, shale	4657
lime	4703
lime, shale	4786
lime	4809
lime, shale	4899
chert	4925
lime, chert	5000
lime, shale	5039
chert, lime	5070
Total Depth	

Tops: S out	
Heebner	4114
Douglas	4149
Brown Lime	4294
Lansing	4307
Miss. chert	4895
Miss. Lime	4992

RECEIVED
STATE CORPORATION COMMISSION
JUN 16 1971
CONSERVATION DIVISION
Wichita, Kansas