


STATE OF KANSAS
STATE CORPORATION COMMISSION

WELL PLUGGING RECORD

Give All Information Completely
Make Required Affidavit
Mail or Deliver Report to
Conservation Division
State Corporation Comm.
245 North Water
Wichita, KS 67202

Kiowa County, Sec. 29 Twp. 29S Rge. 18 NE/W
Location as "NE/CNW $\frac{1}{4}$ SW $\frac{1}{4}$ " or footage from lines _____

C NW NW
Lease Owner Rains & Williamson Oil Co., Inc.
Lease Name Yost Well No. #1
Office Address 435 Page Court, 220 W. Douglas, Wichita, Ks.
Character of Well (Completed as Oil, Gas or Dry Hole) _____

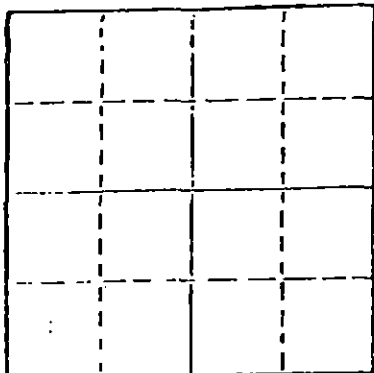

Locate well correctly on above
Section Plot

Dry Hole
Date Well completed 10-10-77 19
Application for plugging filed 10-10-77 19
Application for plugging approved 10-10-77 19
Plugging commenced 10-10-77 19
Plugging completed 10-10-77 19

Reason for abandonment of well or producing formation _____
Commercial quantities of oil not found
If a producing well is abandoned, date of last production _____ 19

Was permission obtained from the Conservation Division or its agents before plugging was commenced? Yes

Name of Conservation Agent who supervised plugging of this well Bill Owens, Pratt, Kansas
Producing formation _____ Depth to top _____ Bottom _____ Total Depth of Well 5000'
Show depth and thickness of all water, oil and gas formations.

OIL, GAS OR WATER RECORDS

CASING RECORD

FORMATION	CONTENT	FROM	TO	SIZE	PUT IN	PULLED OUT
				8 5/8"	604'	None

Describe in detail the manner in which the well was plugged, indicating where the mud fluid was placed and the method or methods used in introducing it into the hold. If cement or other plugs were used, state the character of same and depth placed, from _____ feet to _____ feet for each plug set.

Plug @ 600' w/40 sx.
Plug @ 40' w/12 sx.
Rat Hole 3 sx.

RECEIVED
STATE CORPORATION COMMISSION
OCT 18 1977 10-18-77

CONSERVATION DIVISION
Wichita, Kansas

(If additional description is necessary, use BACK of this sheet)

Name of Plugging Contractor Rains & Williamson Oil Co., Inc.

STATE OF Kansas COUNTY OF Sedgwick, ss.

Wilson Rains, President of Rains & Williamson Oil Co., Inc. (employee of owner) or (owner or operator) of the above-described well, being first duly sworn on oath, says: That I have knowledge of the facts, statements, and matters herein contained and the log of the above-described well as filed and that the same are true and correct. So help me God.

(Signature) Wilson Rains

435 Page Court, 220 W. Douglas, Wichita, Ks. 67202
(Address)

SUBSCRIBED AND SWORN TO before me this 14 day of October, 1977

Juanita M. Green
Notary Public.

My commission expires 10-4-79



DRILLER'S LOG

COMPANY: Rains & Williamson Oil Co., Inc. SEC. 29 T. 29S R. 18W
WELL NAME: Yost #1 LOC. C NW NW
COUNTY: Kiowa

RIG NO. #2

TOTAL DEPTH 5000' ELEVATION

COMMENCED: 9-29-77 COMPLETED: 10-10-77

CONTRACTOR: Rains & Williamson Oil Co., Inc.

CASING RECORD:

SURFACE: 8 5/8" @ 604' w/200 sx. Lite, 3% cc. and 150 sx. common, 3% cc.

PRODUCTION: D&A

LOG

(Figures Indicate Bottom of Formations)

Shale & Sand	620
Shale	1839
Lime & Shale	2510
Shale & Lime	2705
Shale	3300
Shale & Lime	3930
Lime & Shale	4230
Shale & Lime	4375
Lime & Shale	4719
Lime	5000
<u>ROTARY TOTAL DEPTH</u>	<u>5000</u>

RECEIVED
CORPORATION COMMISSION
OCT 18 1977
CONSERVATION DIVISION
Wichita, Kansas

STATE OF Kansas)
COUNTY OF Sedgwick) SS:

I, Wilson Rains, President of Rains & Williamson Oil Co., Inc.
upon oath state that the above and foregoing is a true and correct copy of the log of the
Yost #1 well.

Wilson Rains
Wilson Rains

Subscribed and sworn to before me this 14 day of October, 1977.

My Appointment Expires:
10-4-79

Juanita M. Green
Juanita M. Green

